


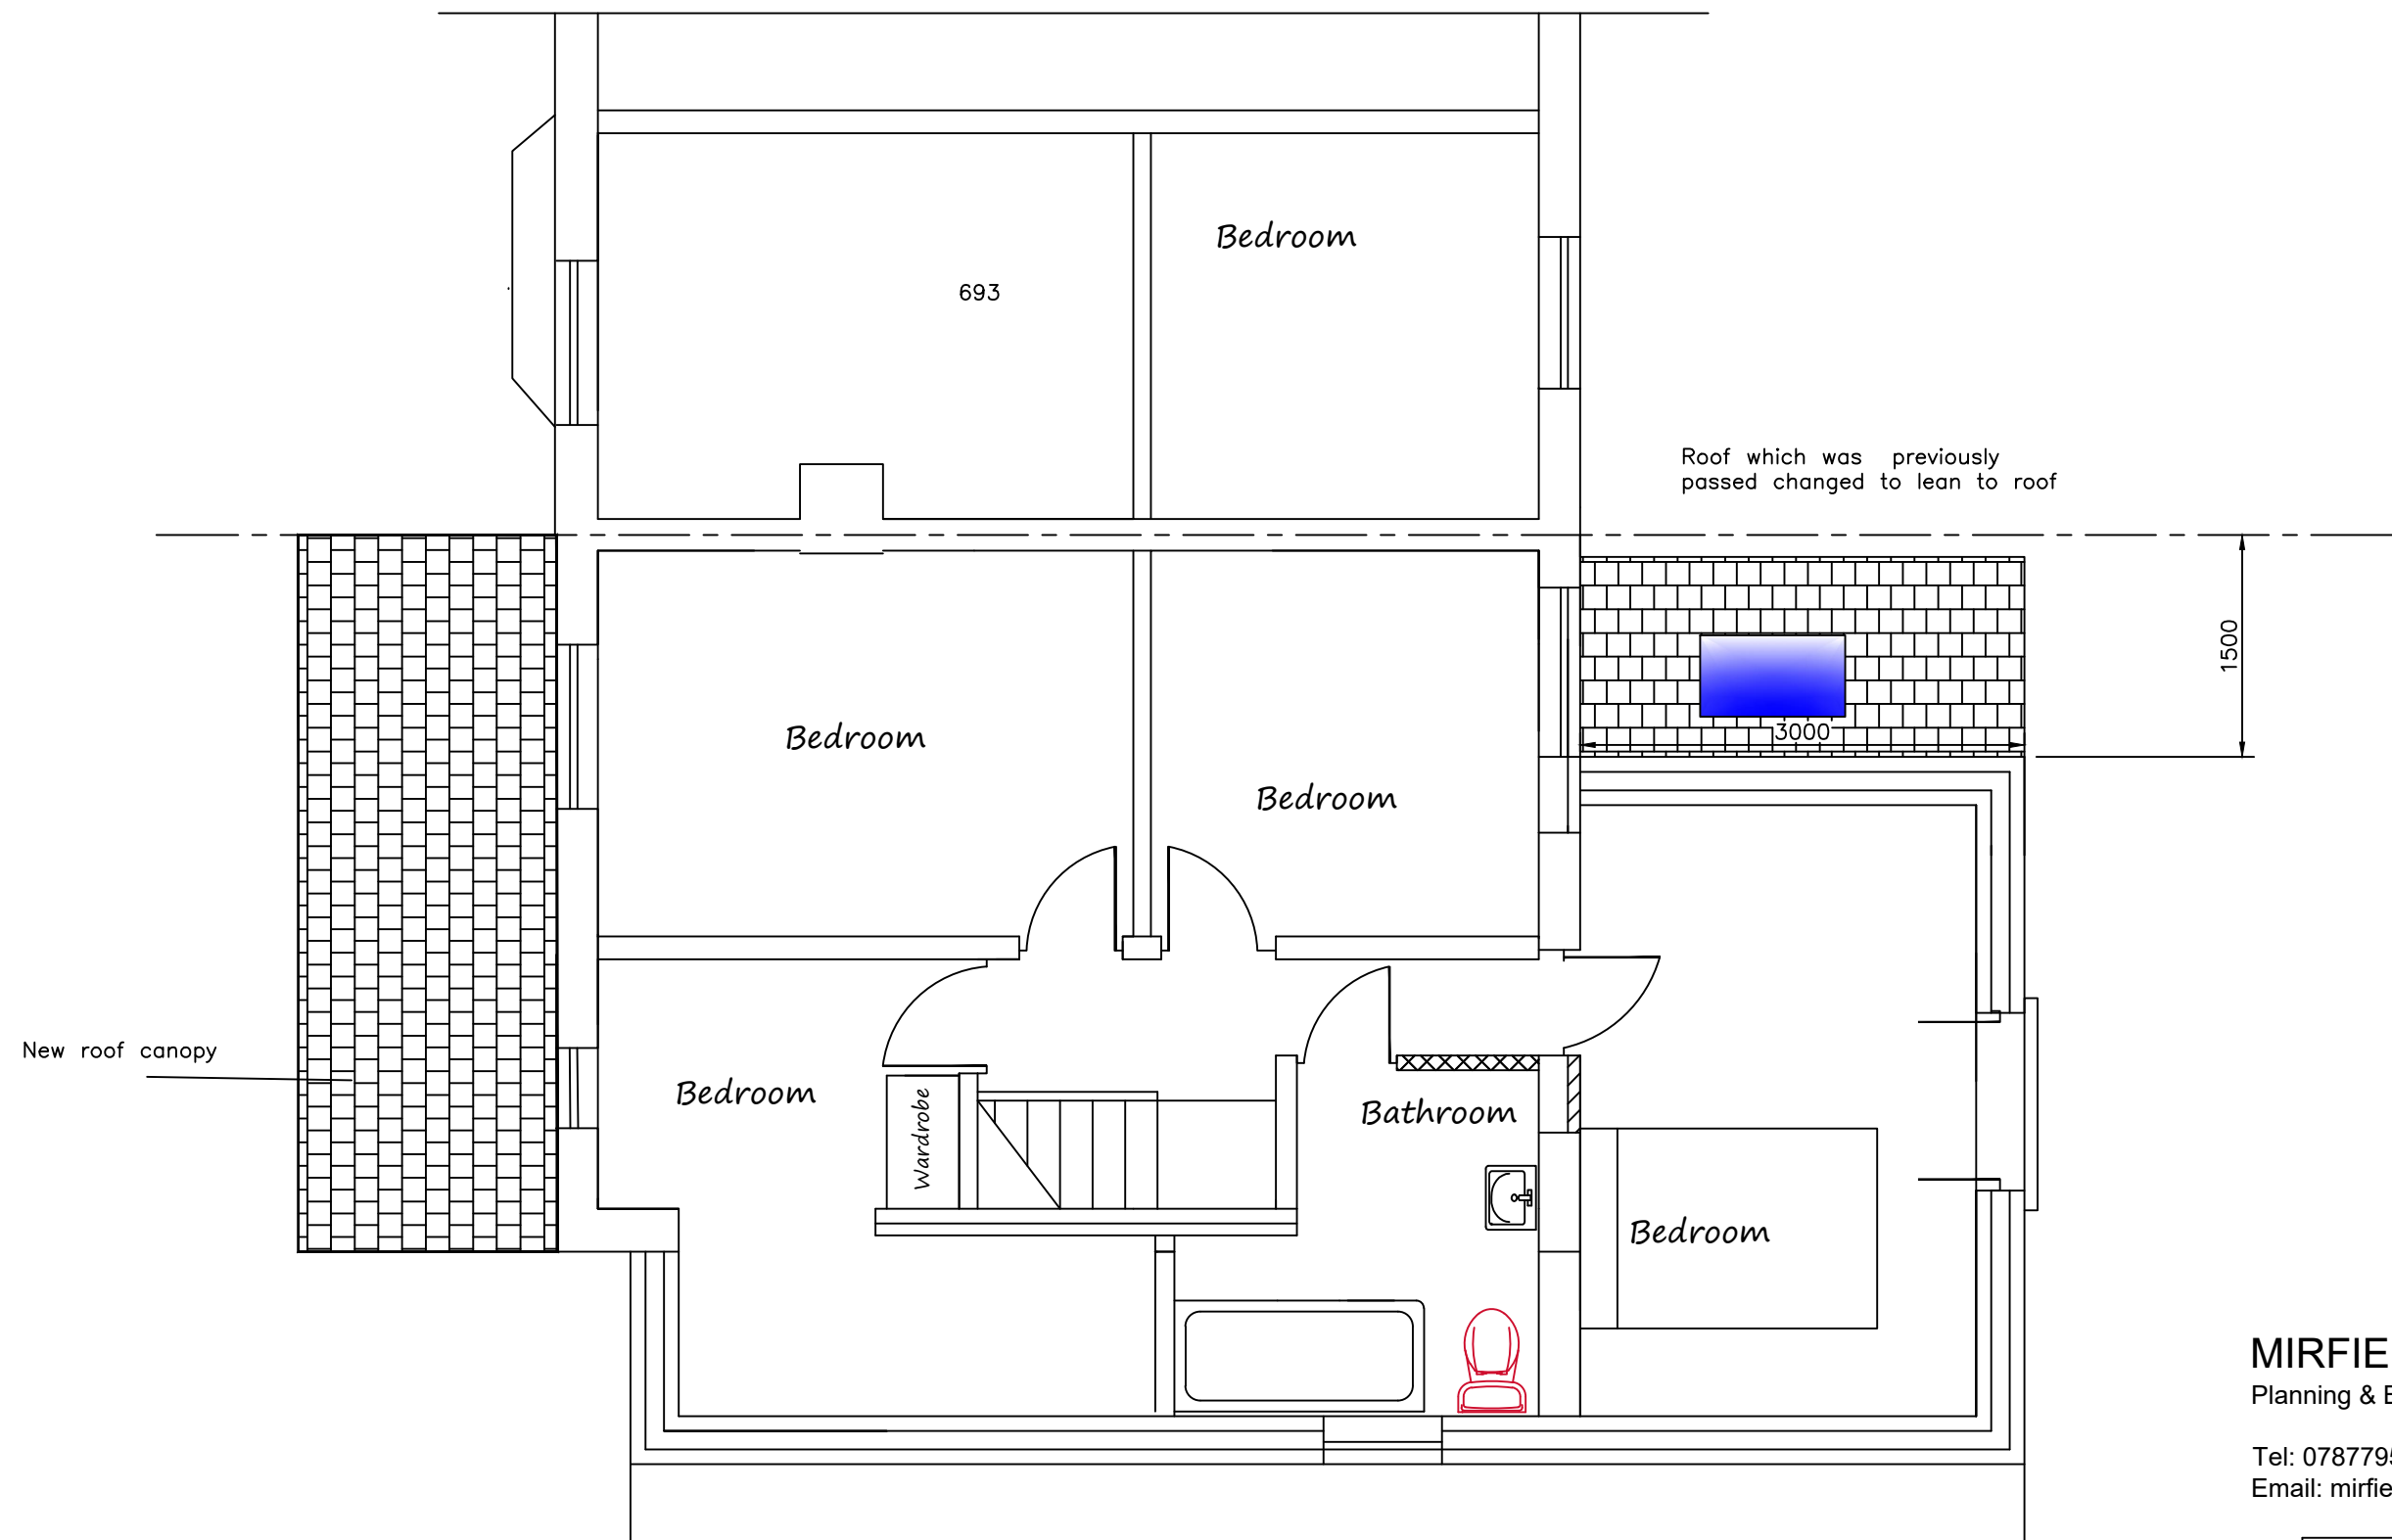

First Floor Plan as Built

1:50

MIRFIELD DESIGNS
Planning & Building Control Service:

Tel: 07877959728
Email: mirfelddesigns@gmail.com

Client Mr & Mrs Monga					
Job 695 Leeds Road Huddersfield					
Title First Floor Plan As Built					
Drawn By RK	Date April 2025				
Eng. Check	Scale 1:50				
Tech. Check					
Drawing No. 2025 / 486 / 06	Rev. <table border="1"> <tr> <td> </td><td> </td></tr> <tr> <td> </td><td> </td></tr> </table>				