


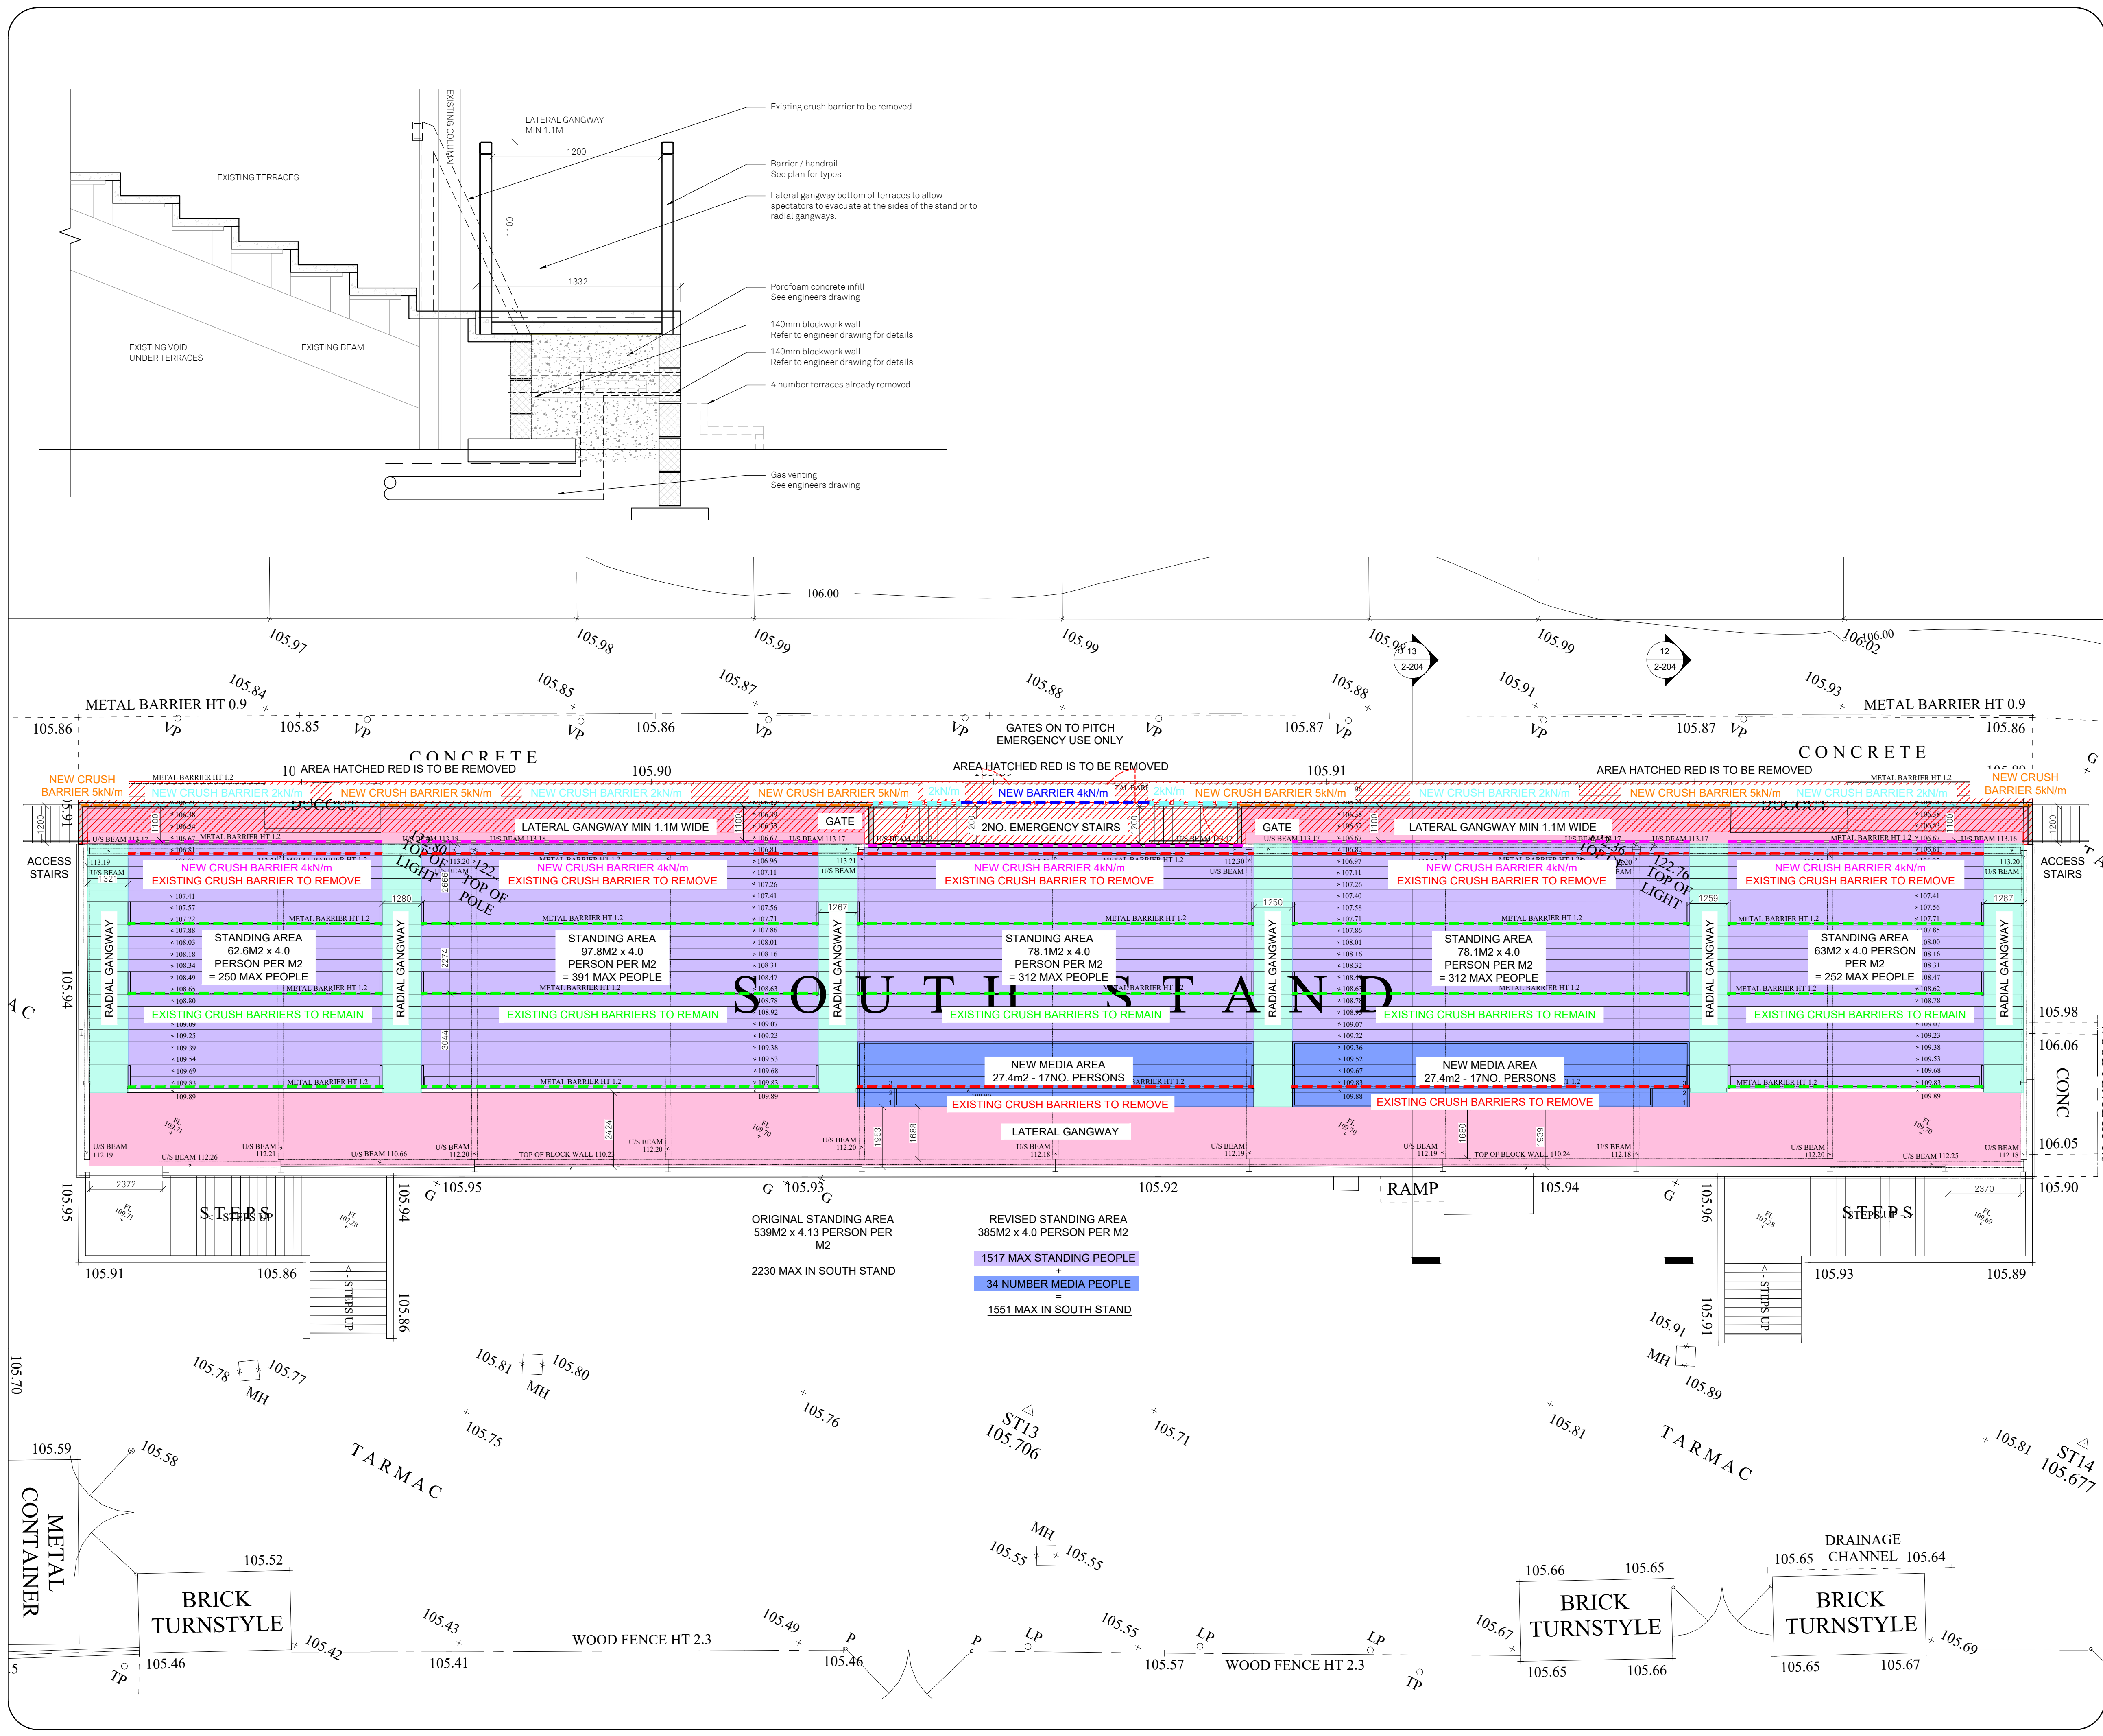

COPYRIGHT RESERVED

Notes

Revisions

Rev	Date	Description
A	SEPT 26	Drawing amended following client meeting
B	SEPT 26	Drawing amended following discussions with BC and FE
C	SEPT 26	Drawing amended to incorporate emergency stair to front of stand Marked up to show new barriers and existing barriers to remain or remove.

BUILDING MANAGEMENT SERVICES LTD

Huddersfield Road
Elland, West Yorkshire
HX5 9BW
TELEPHONE : ELLAND (01422) 371616
FAX No : (01422) 376717
email : mail@bmselland.com

Building Management Services

Client

Commercial Development Projects Ltd

Project

FLAIR Stadium
Owl Lane
Dewsbury

Sheet

South Stand - Max Capacity Analysis - OPT4

Drawn	B.D.L.	Date	AUG 26
Scale	1:100 @ A1		
Status	Planning		
Drawing No.	M3310-2-203	Revision	Rev D