



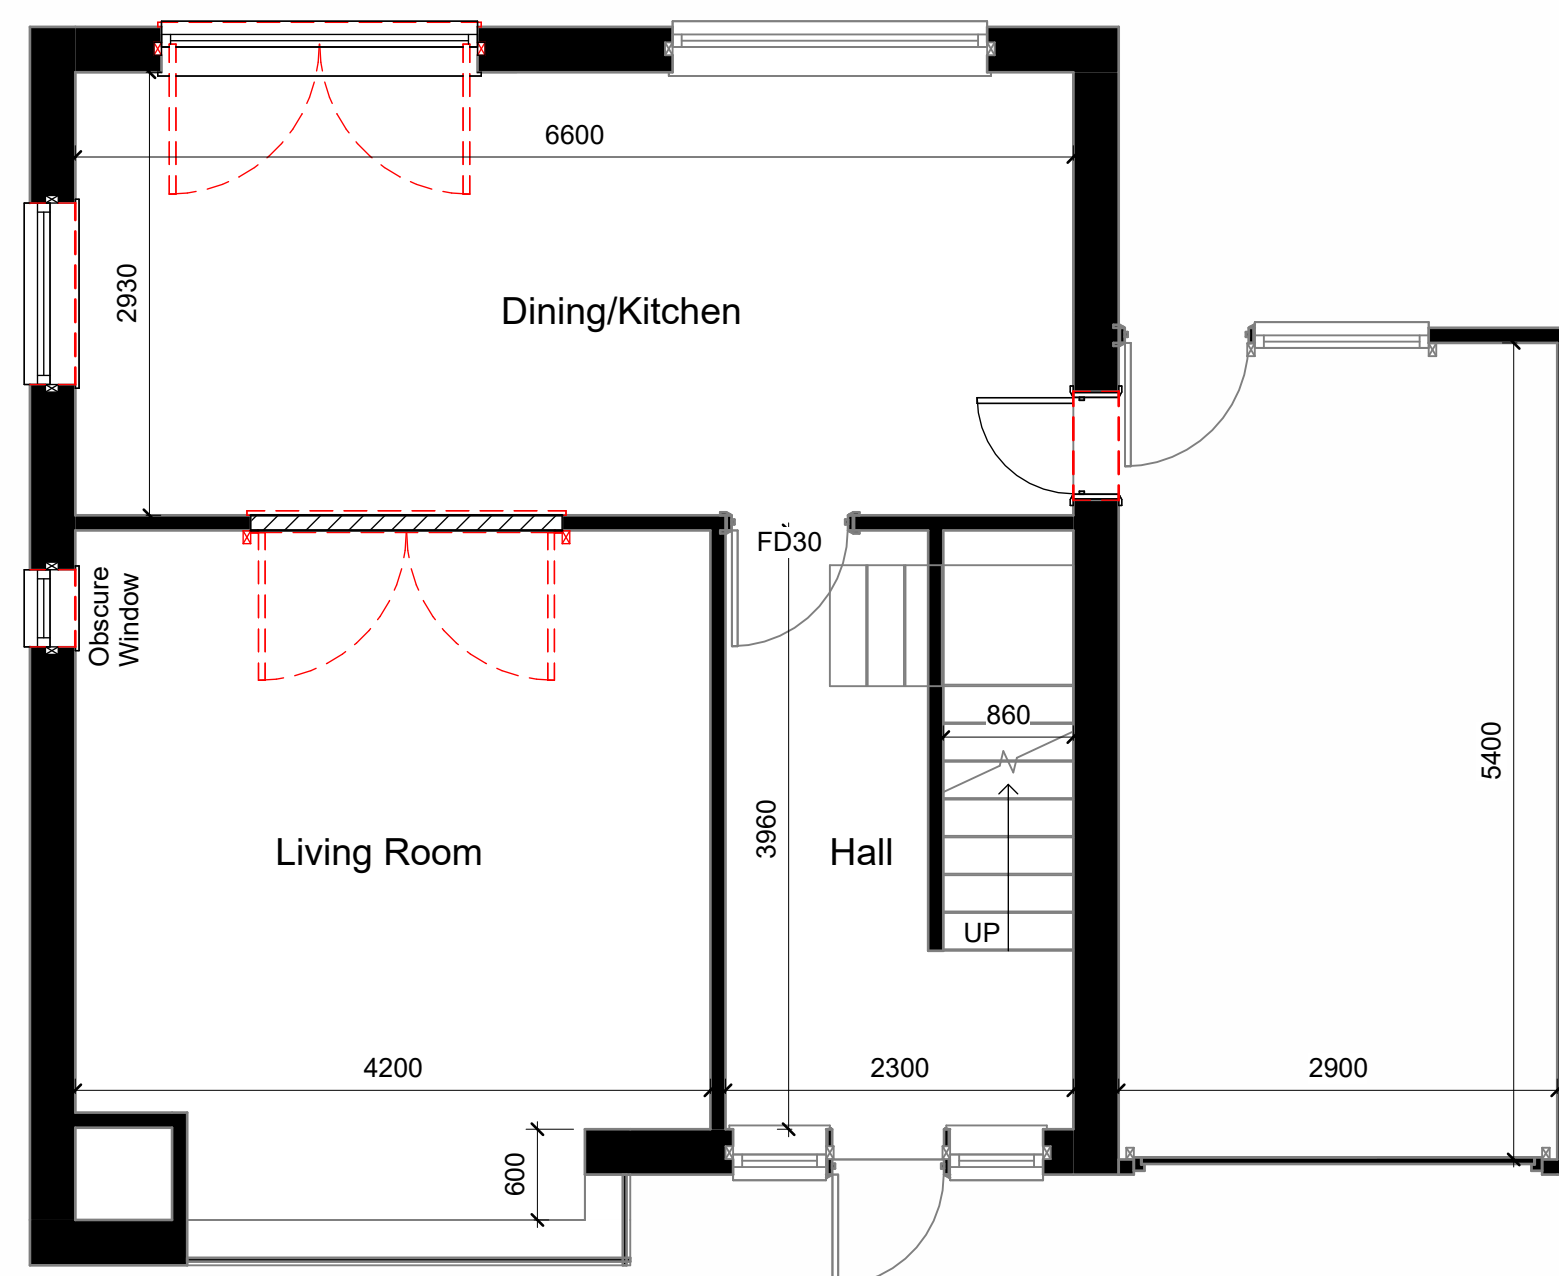


As-Built Ground Floor Plan

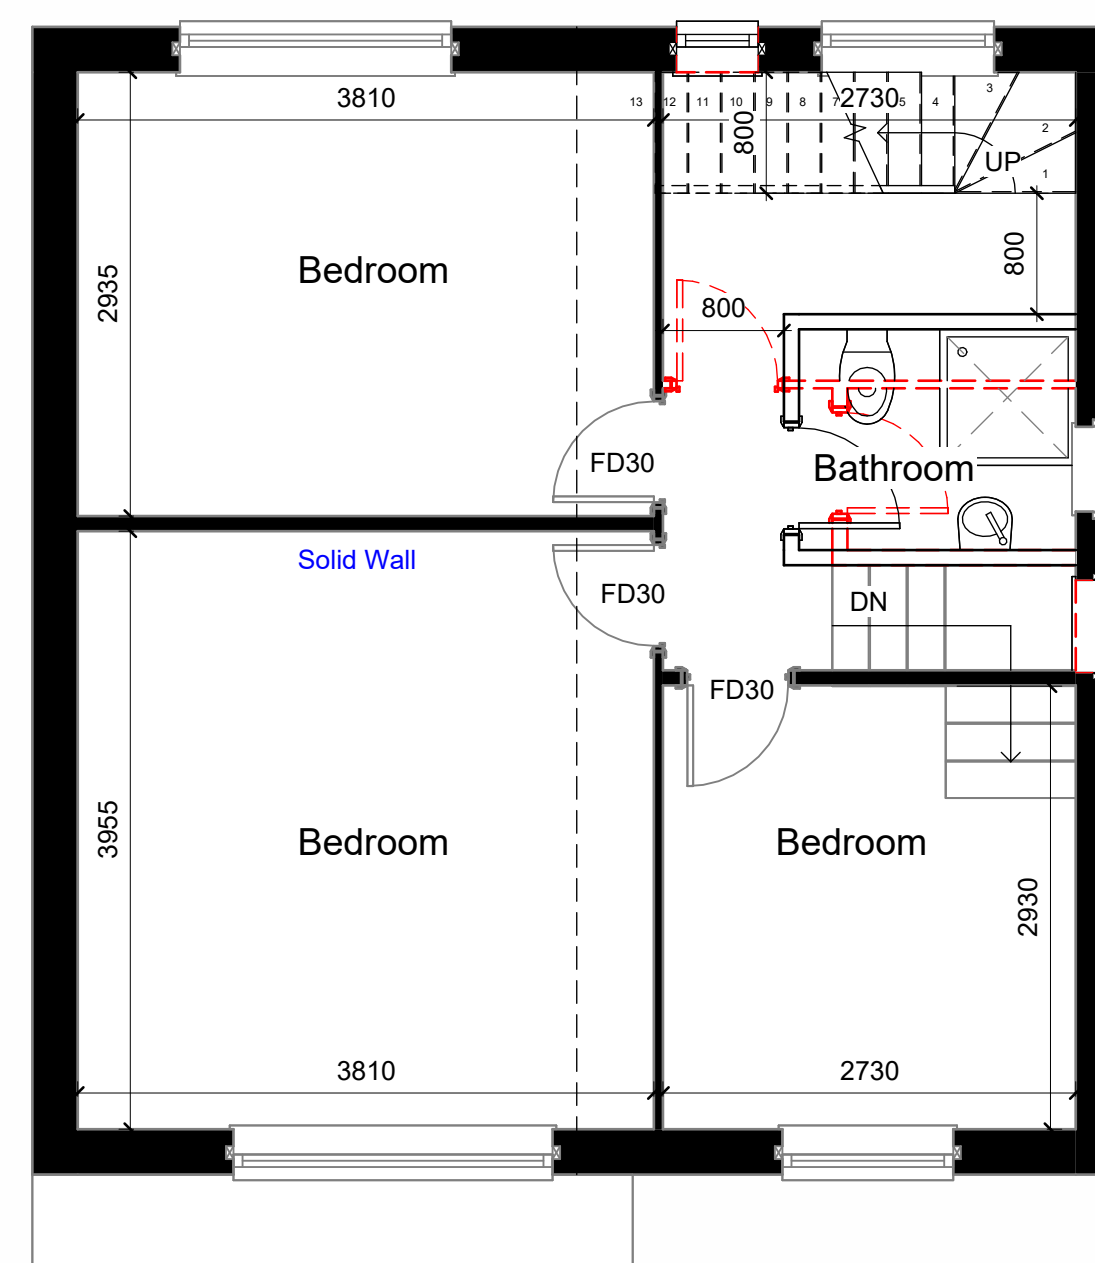


As-Built First Floor Plan

1 : 50

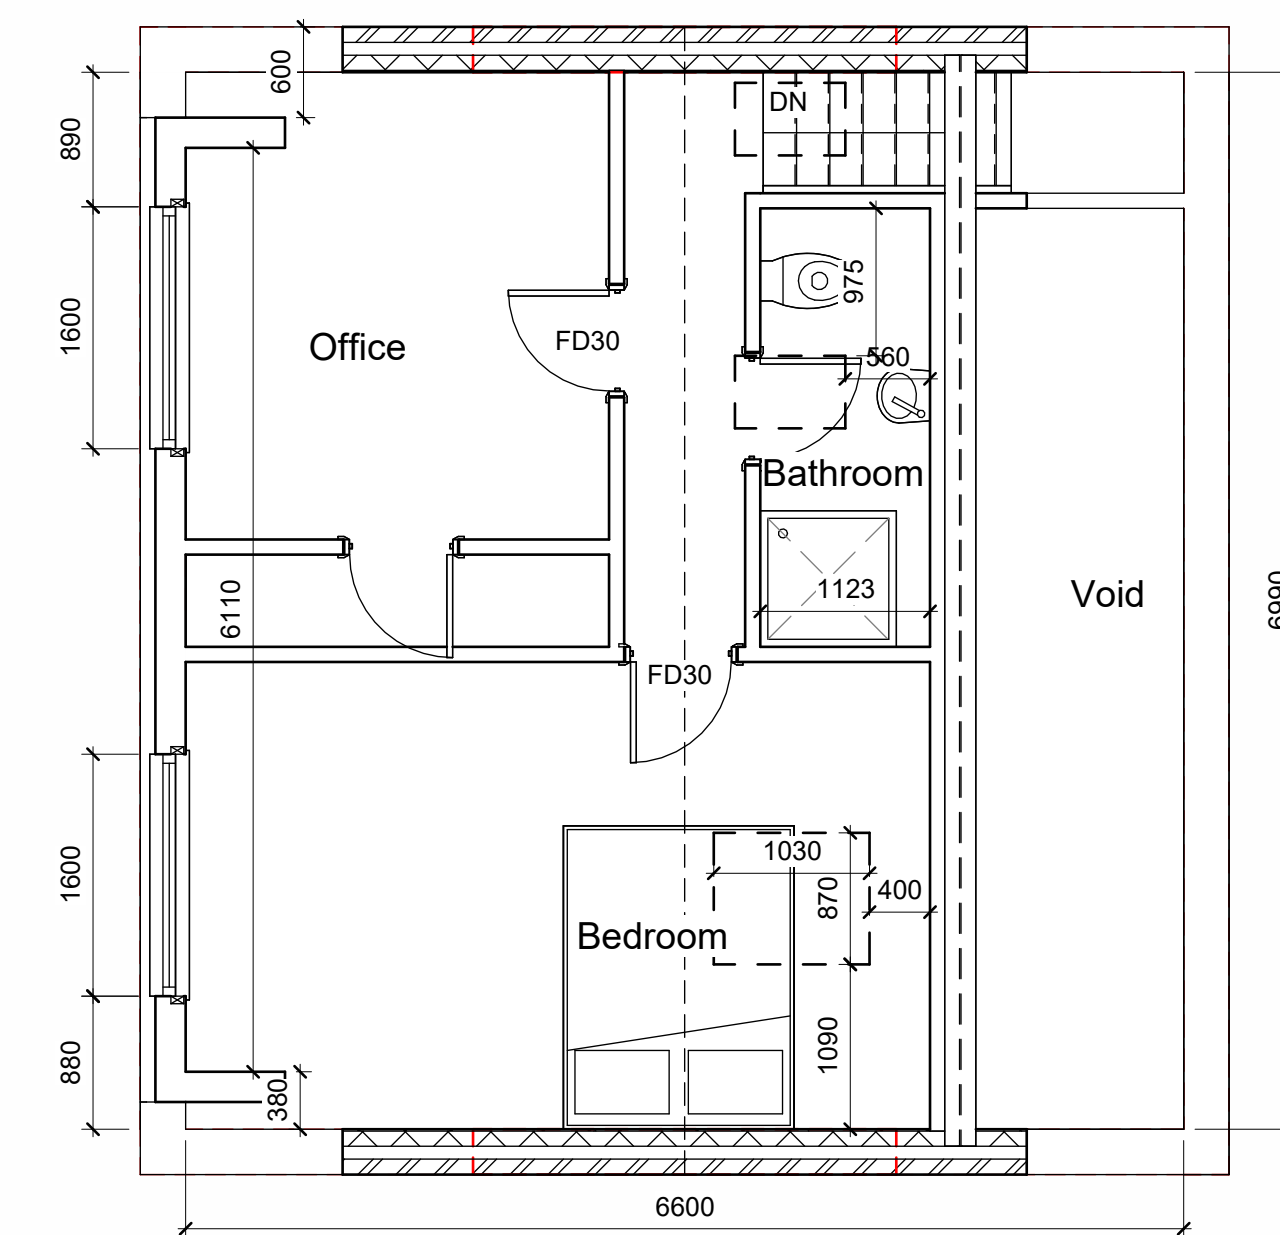

As-Built Attic Plan

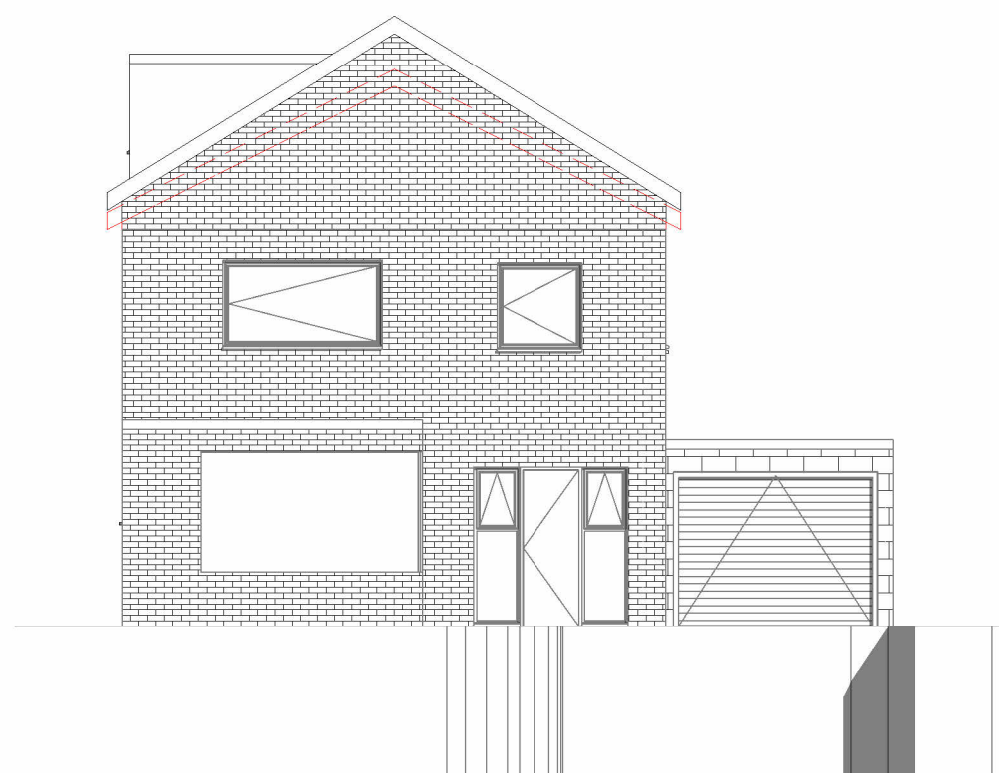


As-Built Front Elevation


1 : 100




As-Built Rear Elevation

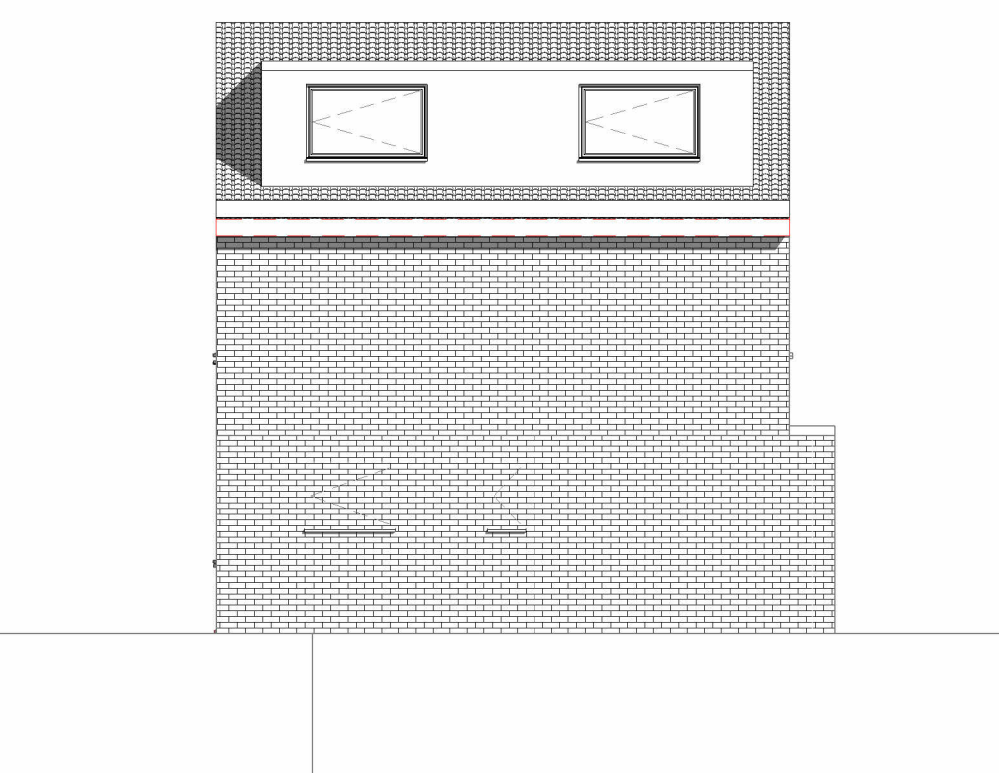

As-Built Left Elevation

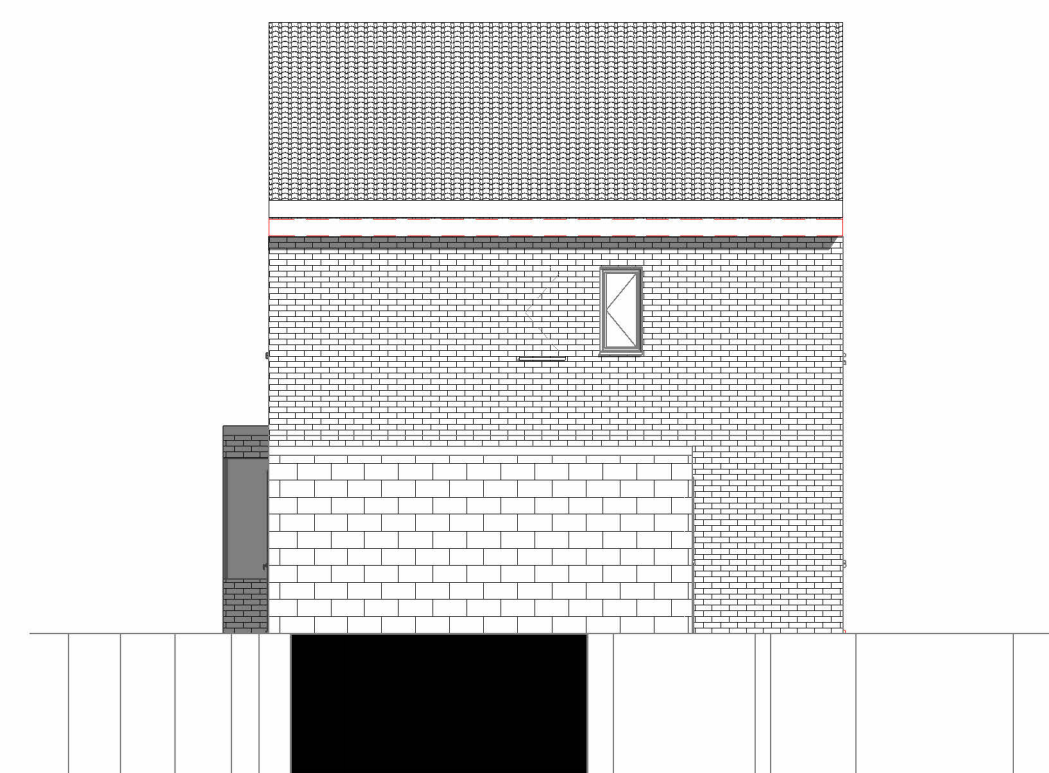

As-Built Right Elevation

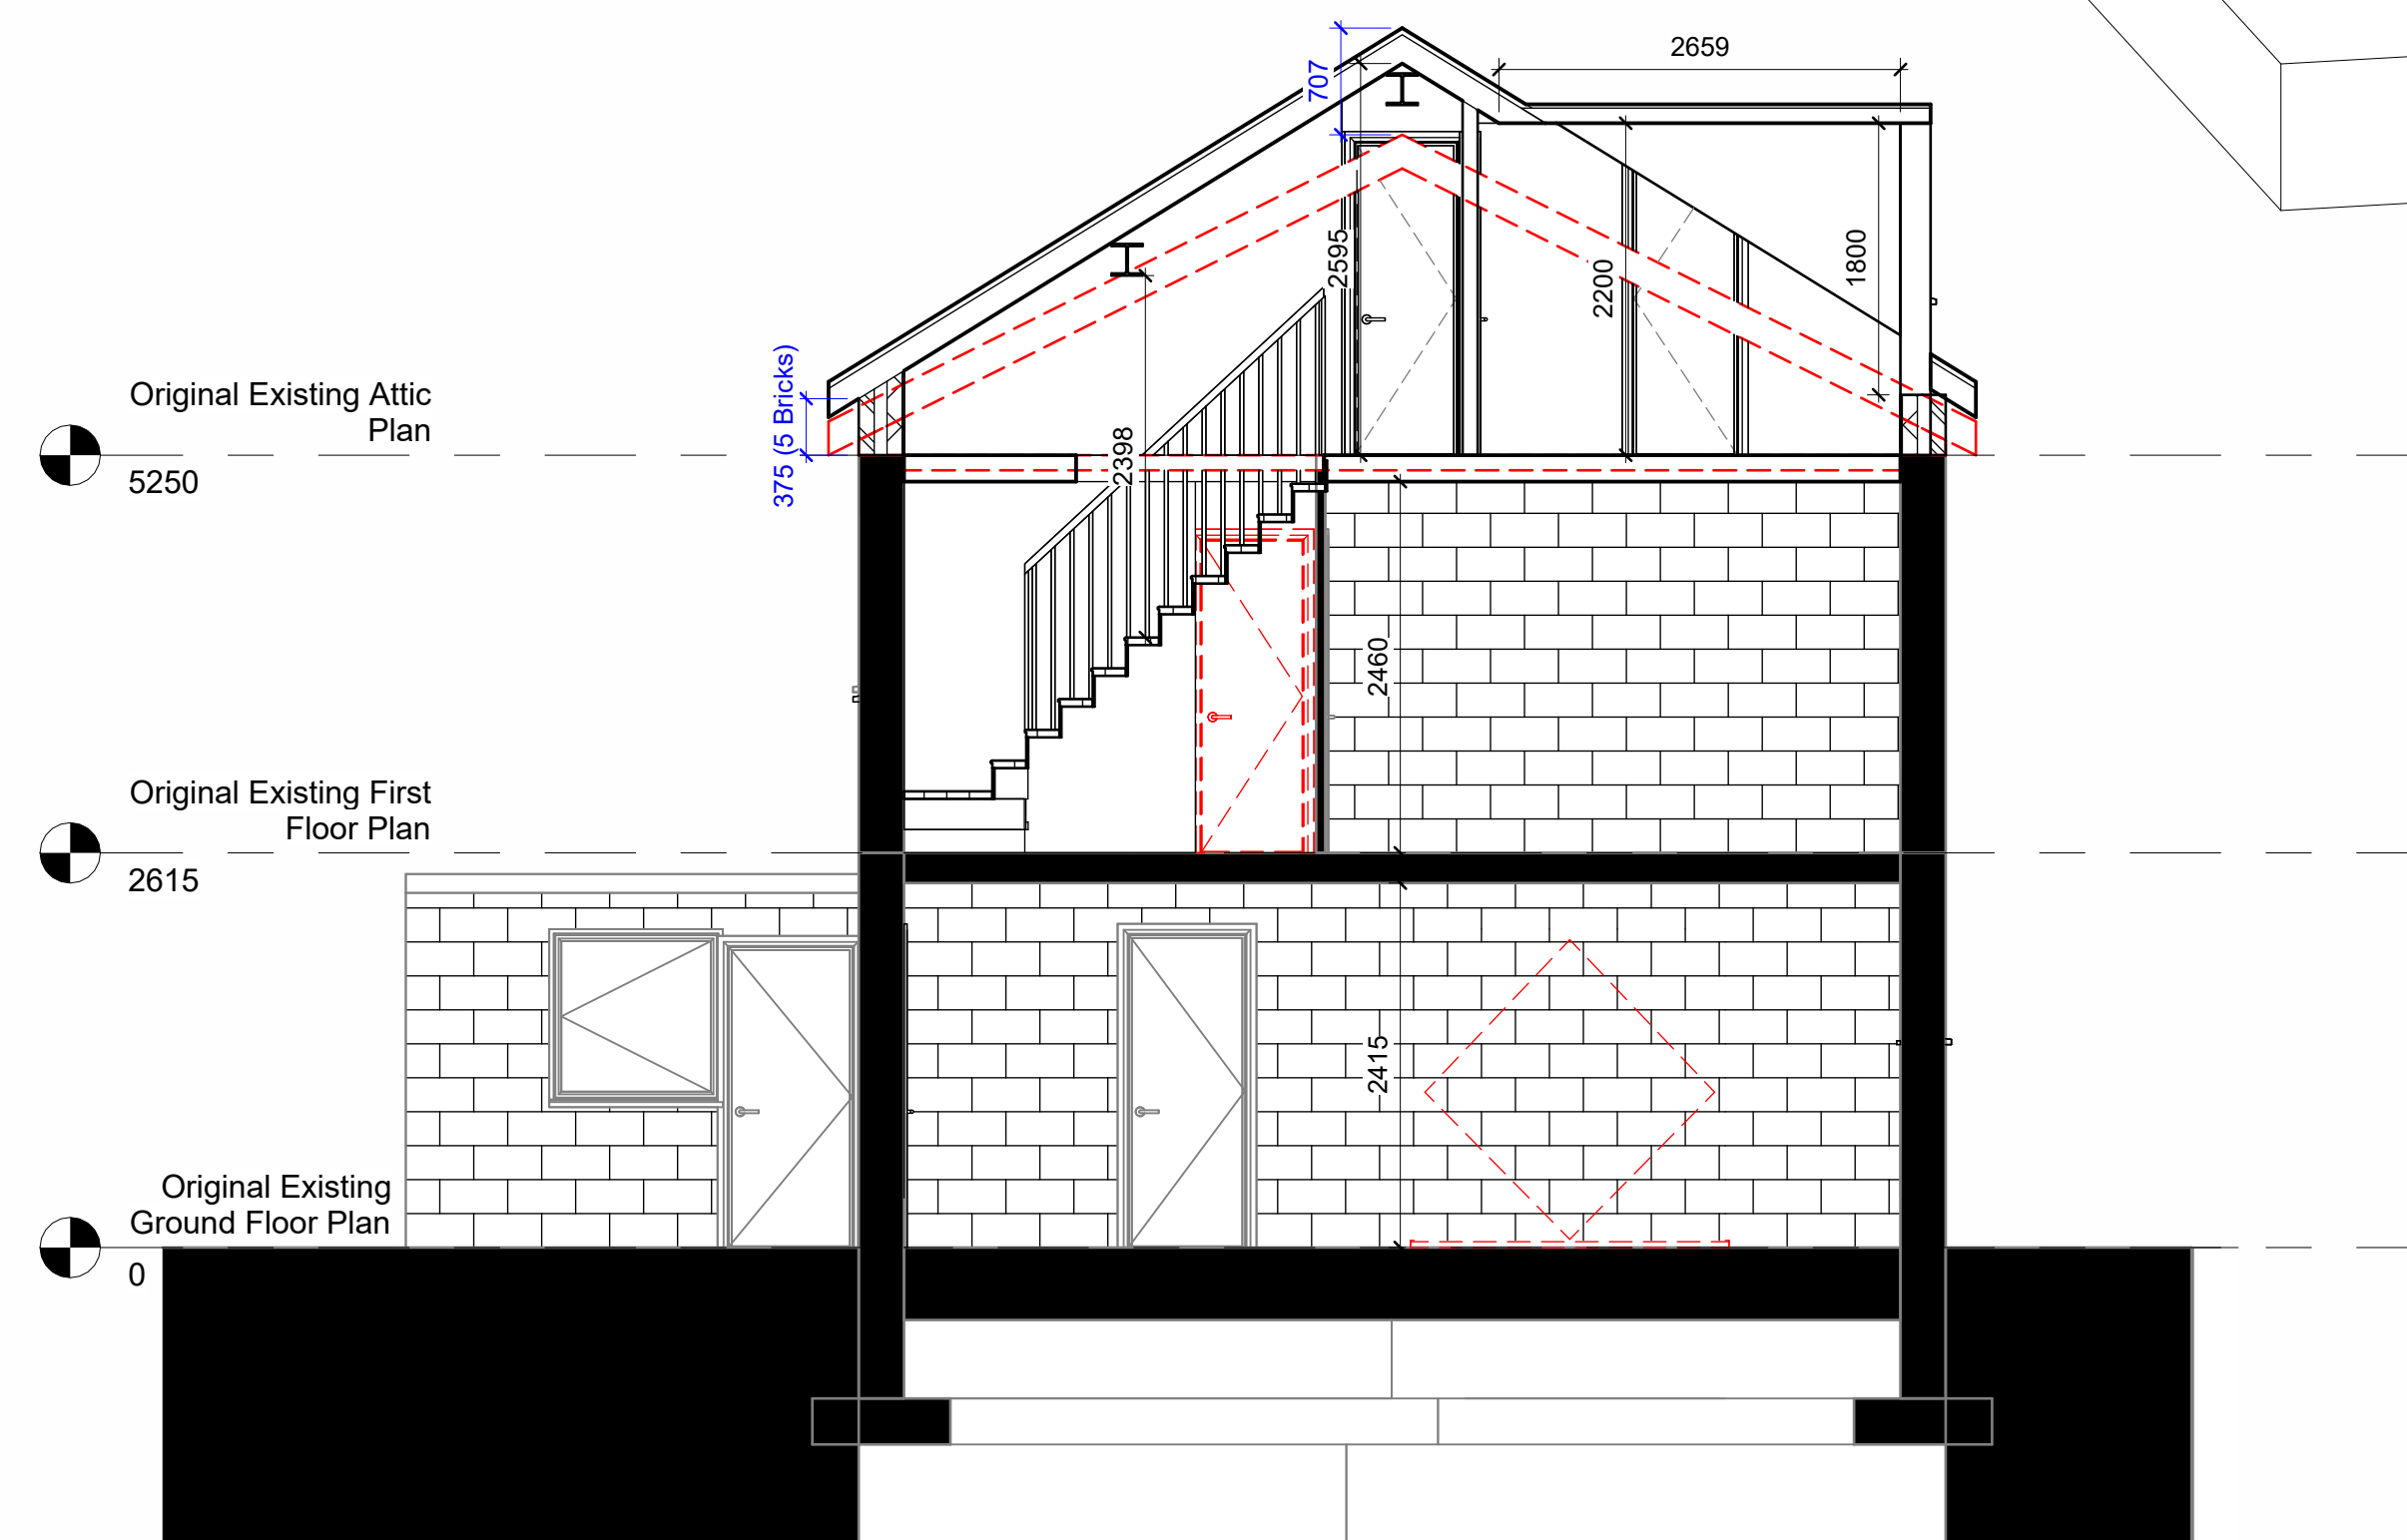

As-Built Section A-A
1 : 50



As-Built 3D

Note:

All Dimensions Are Approximate
And TBC On Site By Contractor



Project Name 65 Springwood Hall Gardens, Huddersfield, HD1 4HA

Drawing Title:
As-Built Grouped Plans

Drawing Number:	Scale:
TR-A26-0402-004	As indicated@A1

Date: 08/10/26	Revision: Approver
----------------	--------------------

Drawn By: AM	Checked by: JA
--------------	----------------

Reason For Issue:
Planning