



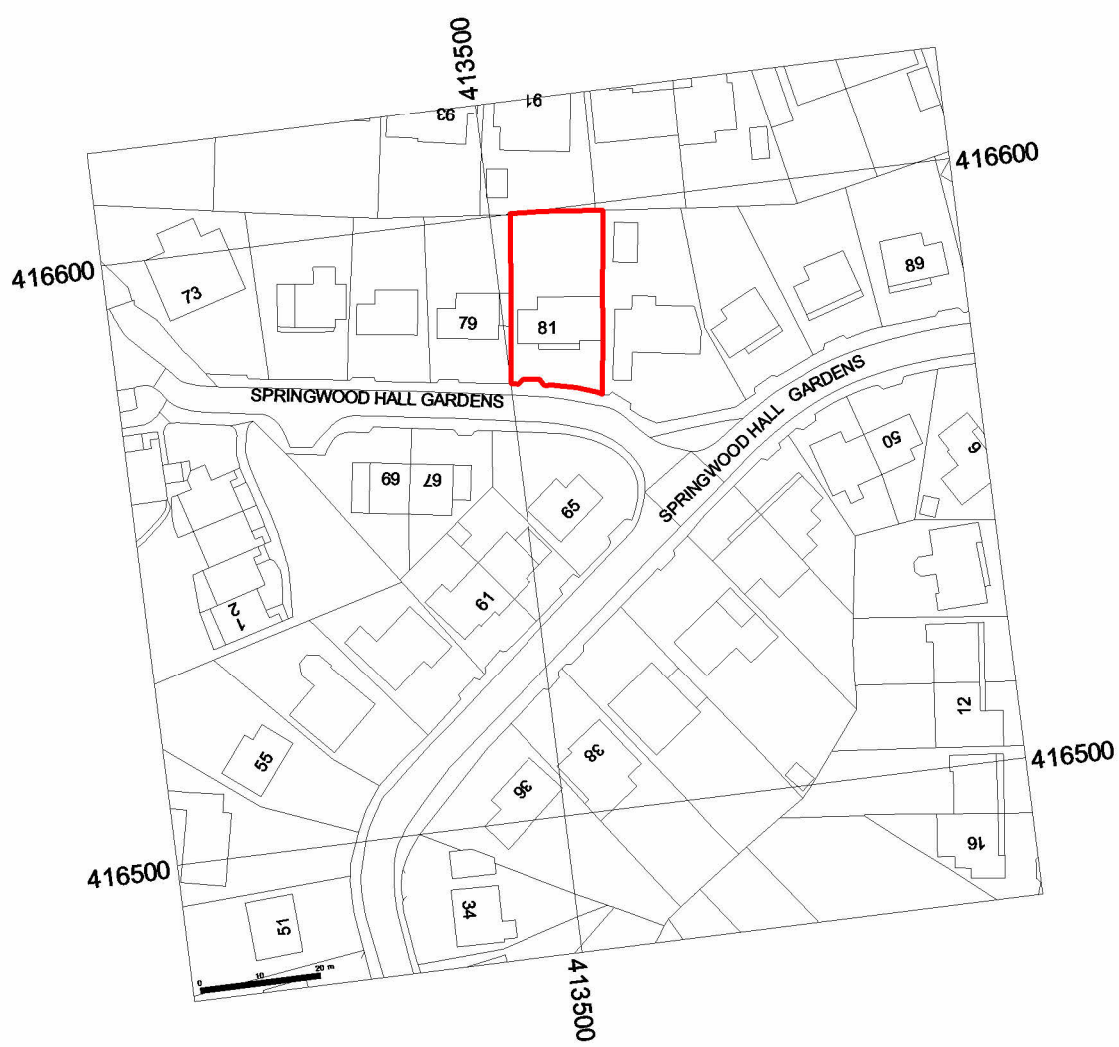

Location Plan
1 : 1250

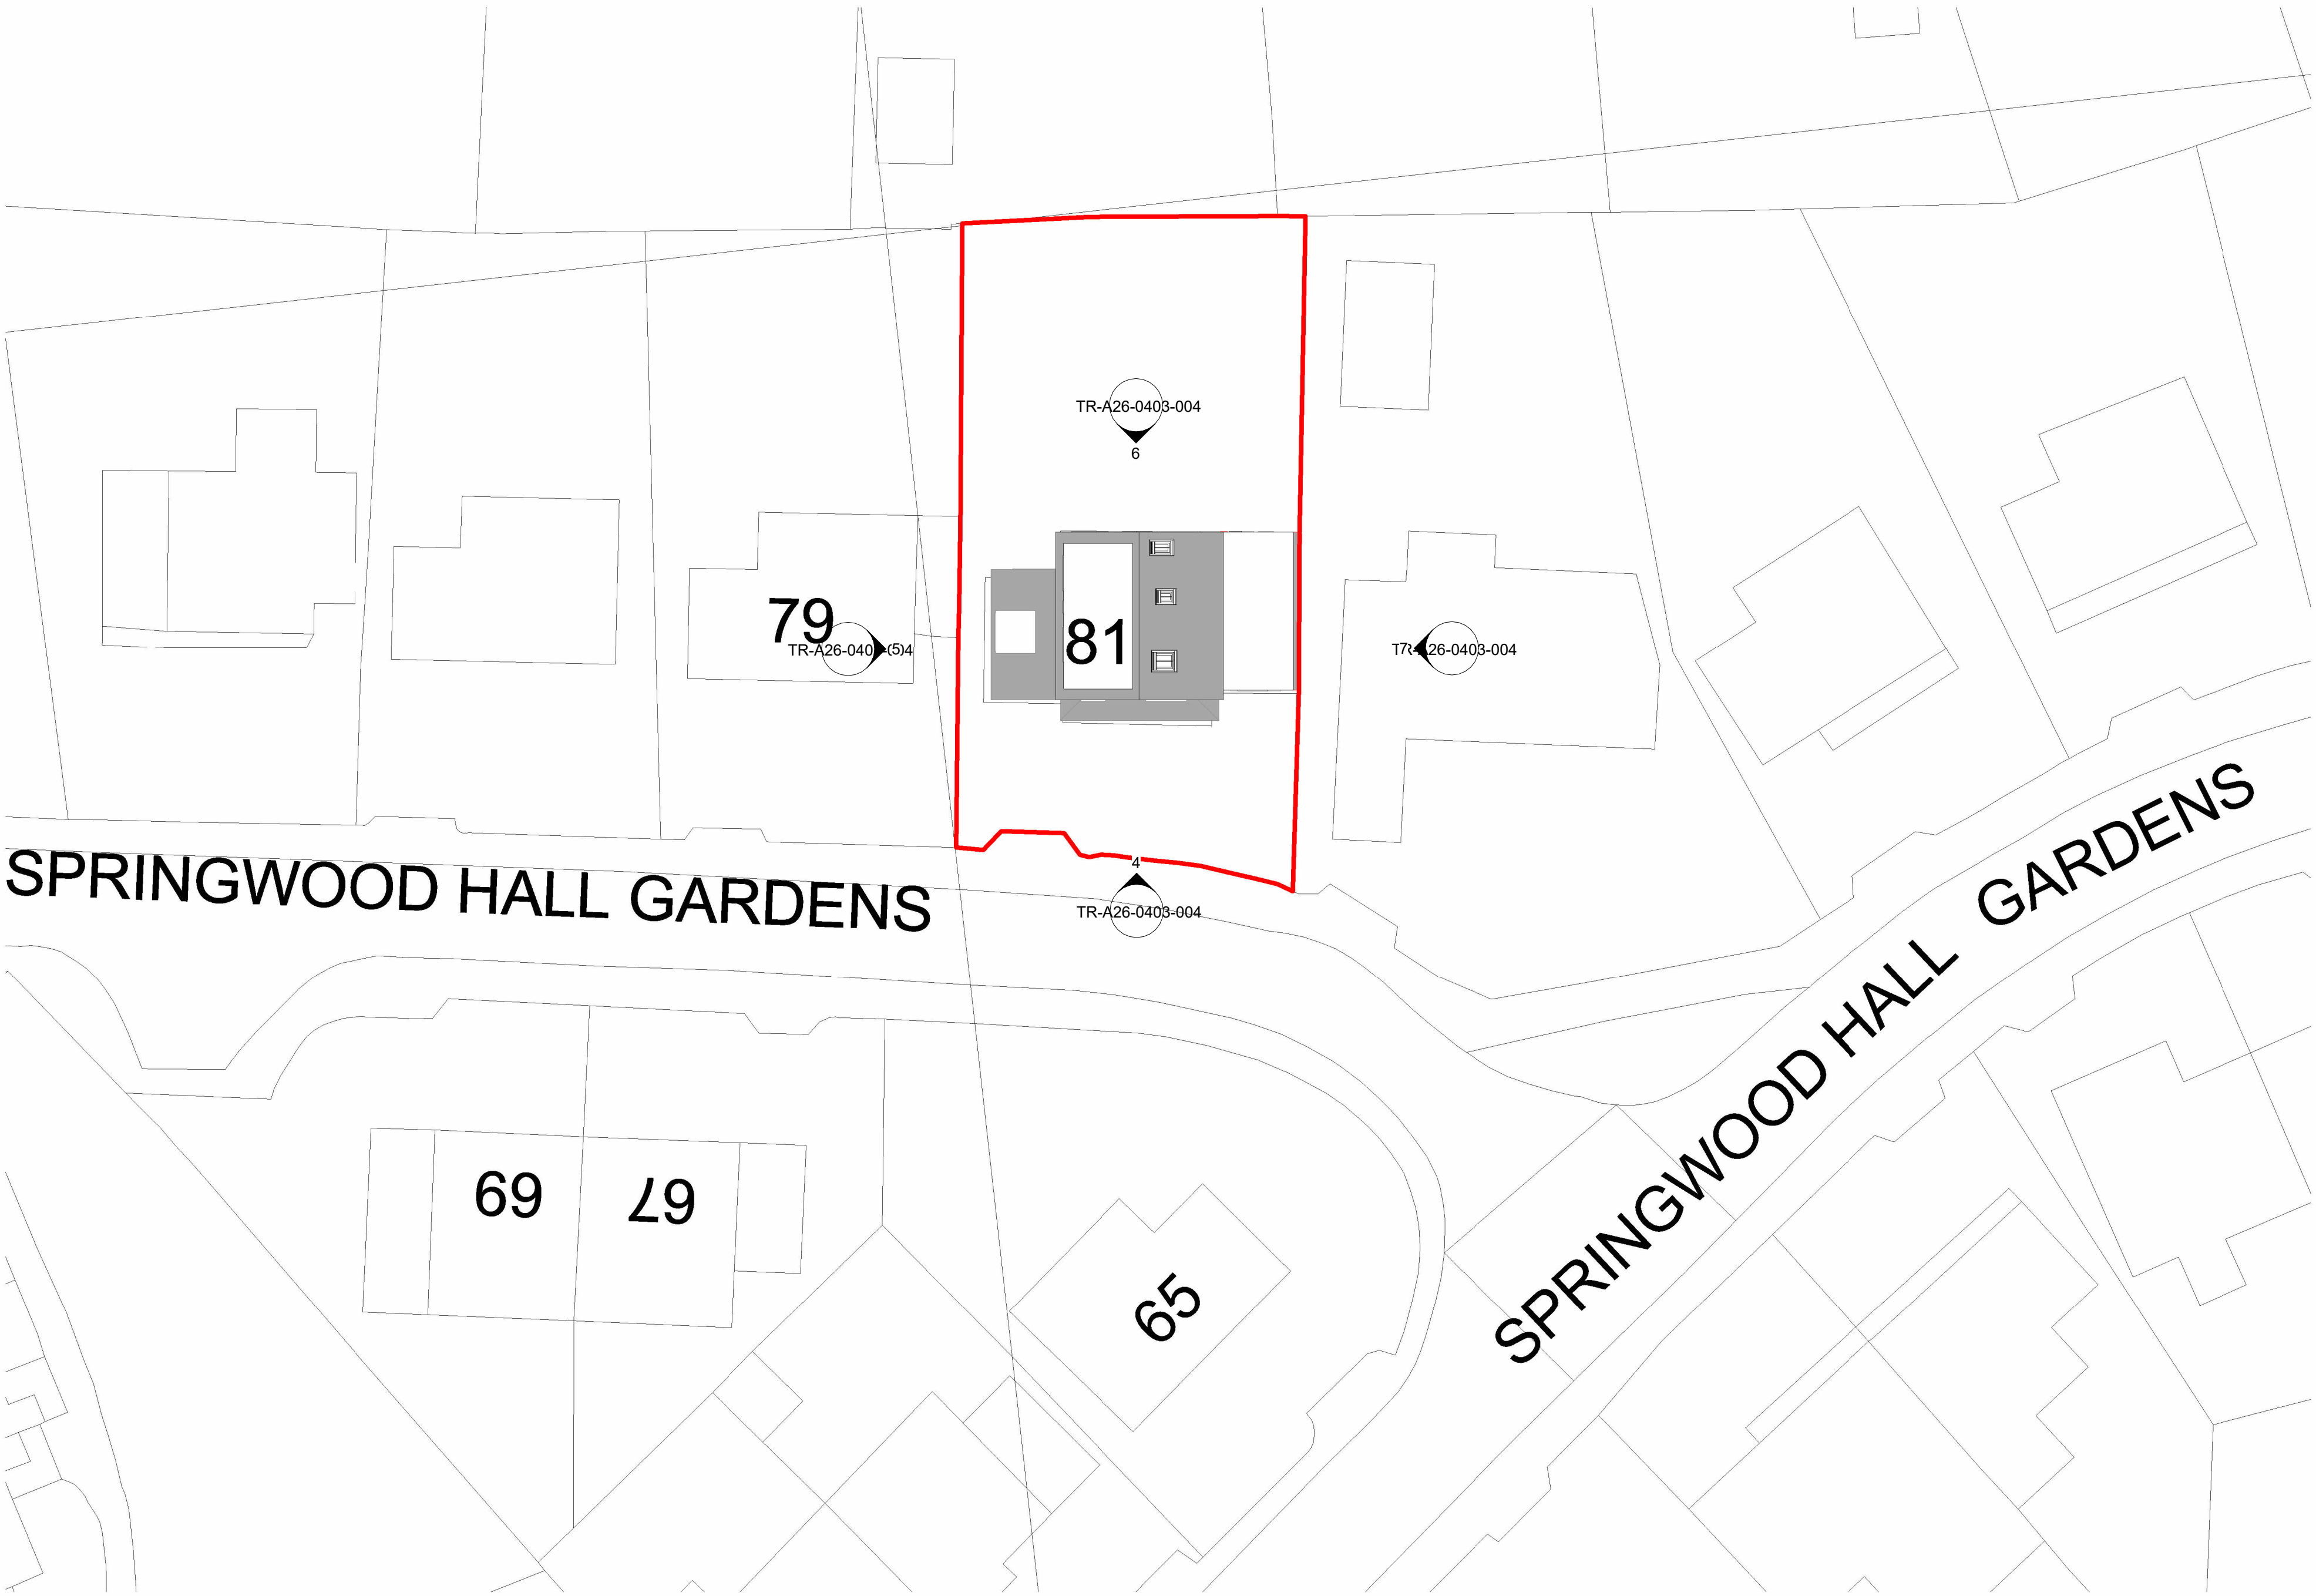

As-Built Site Plan
1 : 200

Note:

All Dimensions Are Approximate
And TBC On Site By Contractor



TREND
ARCHITECTURE
T: 01484 941051
plan@trendarchitecture.co.uk
www.trendarchitecture.co.uk

Naeem Builder
81 Springwood Hall Gardens, Huddersfield, HD1 4HA

Drawing Title:
Location & As-Built Site Plan

Drawing Number: TR-A26-0403-003	Scale: As indicated@A1
------------------------------------	---------------------------

Date: 07/10/26	Revision: Approver
----------------	--------------------

Drawn By: AM	Checked by: JA
--------------	----------------

Reason For Issue: