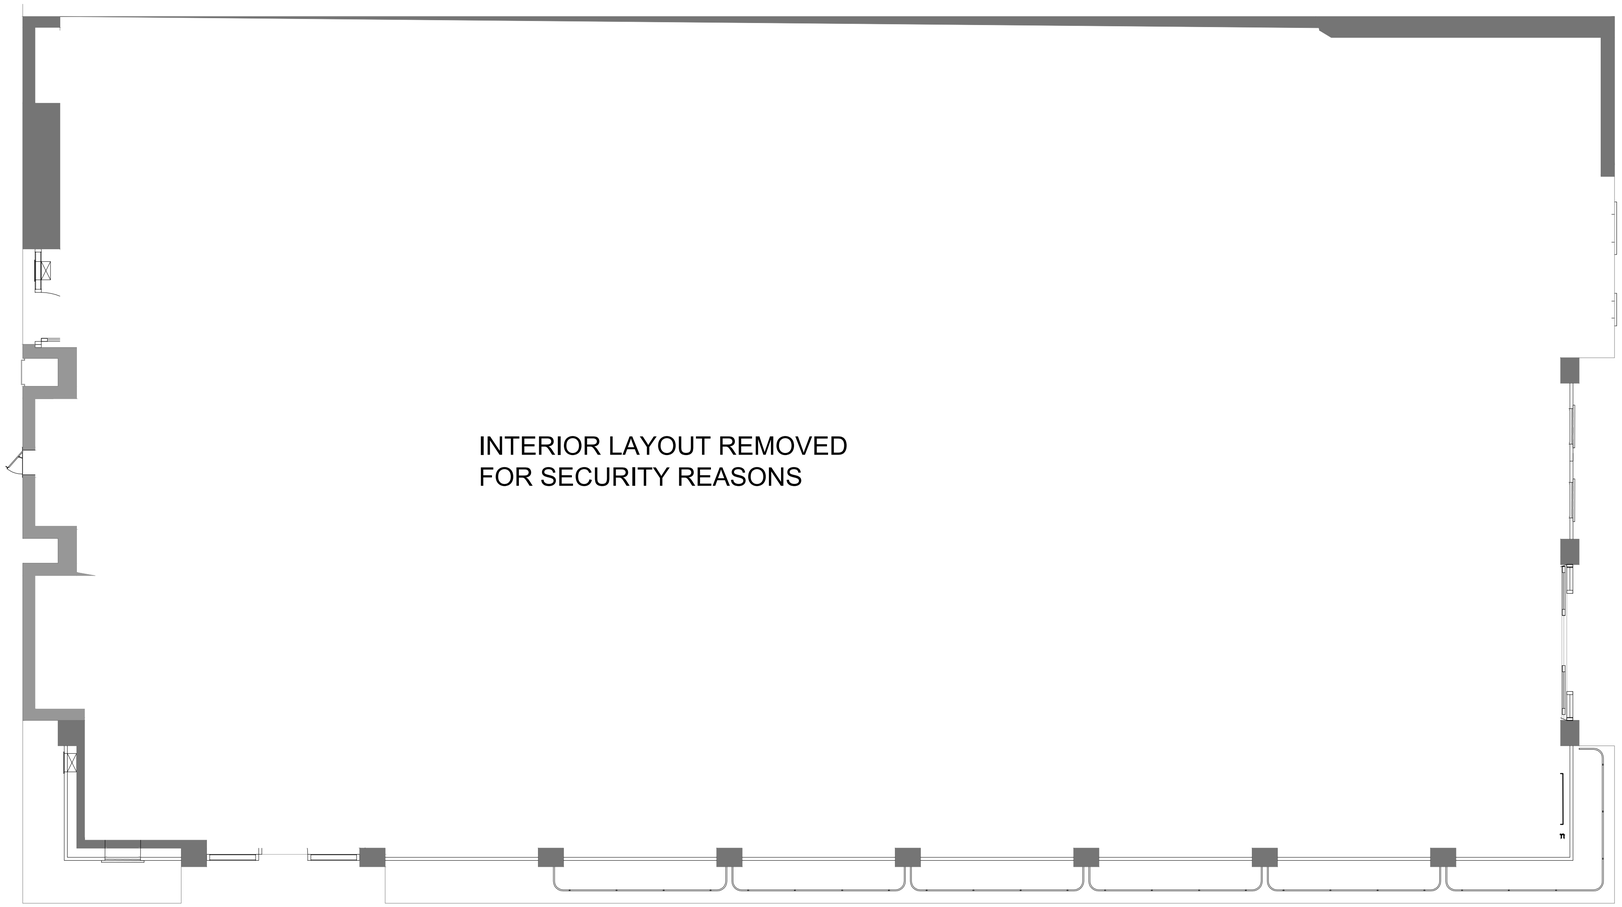


Partition Key

= Existing Walls
= New Partition
= New Secure Partition (Mesh)
= New Secure Partition (Steel)
= New Glazed Partition

Back Office Desk Number Key

PG01-E - Existing position on ground floor.
PG01-P - Proposed position on ground floor.

- Hearing Loop ('P' indicates portable device)

Existing Door | New Door | Existing Door with works

Door Key

DG01-E - Existing door located on the ground floor.
DG02-P - Proposed door located on the ground floor.

Window Key

WG01-E - Existing window located on the ground floor.
WG02-P - Proposed window located on the ground floor.

0 1 2 3 4 5 6 7 8 9 10

Scale - meters

Notes:

Copyright of this drawing is reserved by AXIS Architecture and issued on the condition that it is not copied, reproduced or disclosed to any third party either wholly or in part without the consent in writing of AXIS Architecture.

The contractor must verify all dimensions on site before making shop drawings or commencing work of any kind. No dimensions to be scaled from this drawing.

RESIDUAL RISK

Wherever possible unnecessary risk is designed out of these proposals.
Where residual risk remains this is assessed and identified on the relevant drawings with this symbol.
Refer to the note and the relevant measures in the Health + Safety documentation

Rev	Date	Notes	Rev	Date	Notes

Client: HSBC

Project: Huddersfield
2 Cloth Hall Street
West Yorkshire, HD1 2ES

Title: Existing Plans
Ground Floor

Status: RECORD DRAWING

Scale A1	Scale A3	Date	Drawn	Checked
1:50	1:100	09.11.2015		

Job No.: 027-GF-EX
Revision: -

AXIS Architecture and Design Ltd,
Talbot Chambers,
2-6 North Church Street,
Sheffield, S1 2DH.

tel: +44(0)114 2490944
fax: +44(0)114 2490966
www.axis-architecture.com
designed@axis-architecture.com

AXIS architecture

X:\2077_HSBC\UK_Refresh\027-Huddersfield\Cloth\Hall\5\CAD\26577-027-HuddersfieldClothHall5f.dwg, 29/06/2016 11:30:28, DWG To PDF.pc3