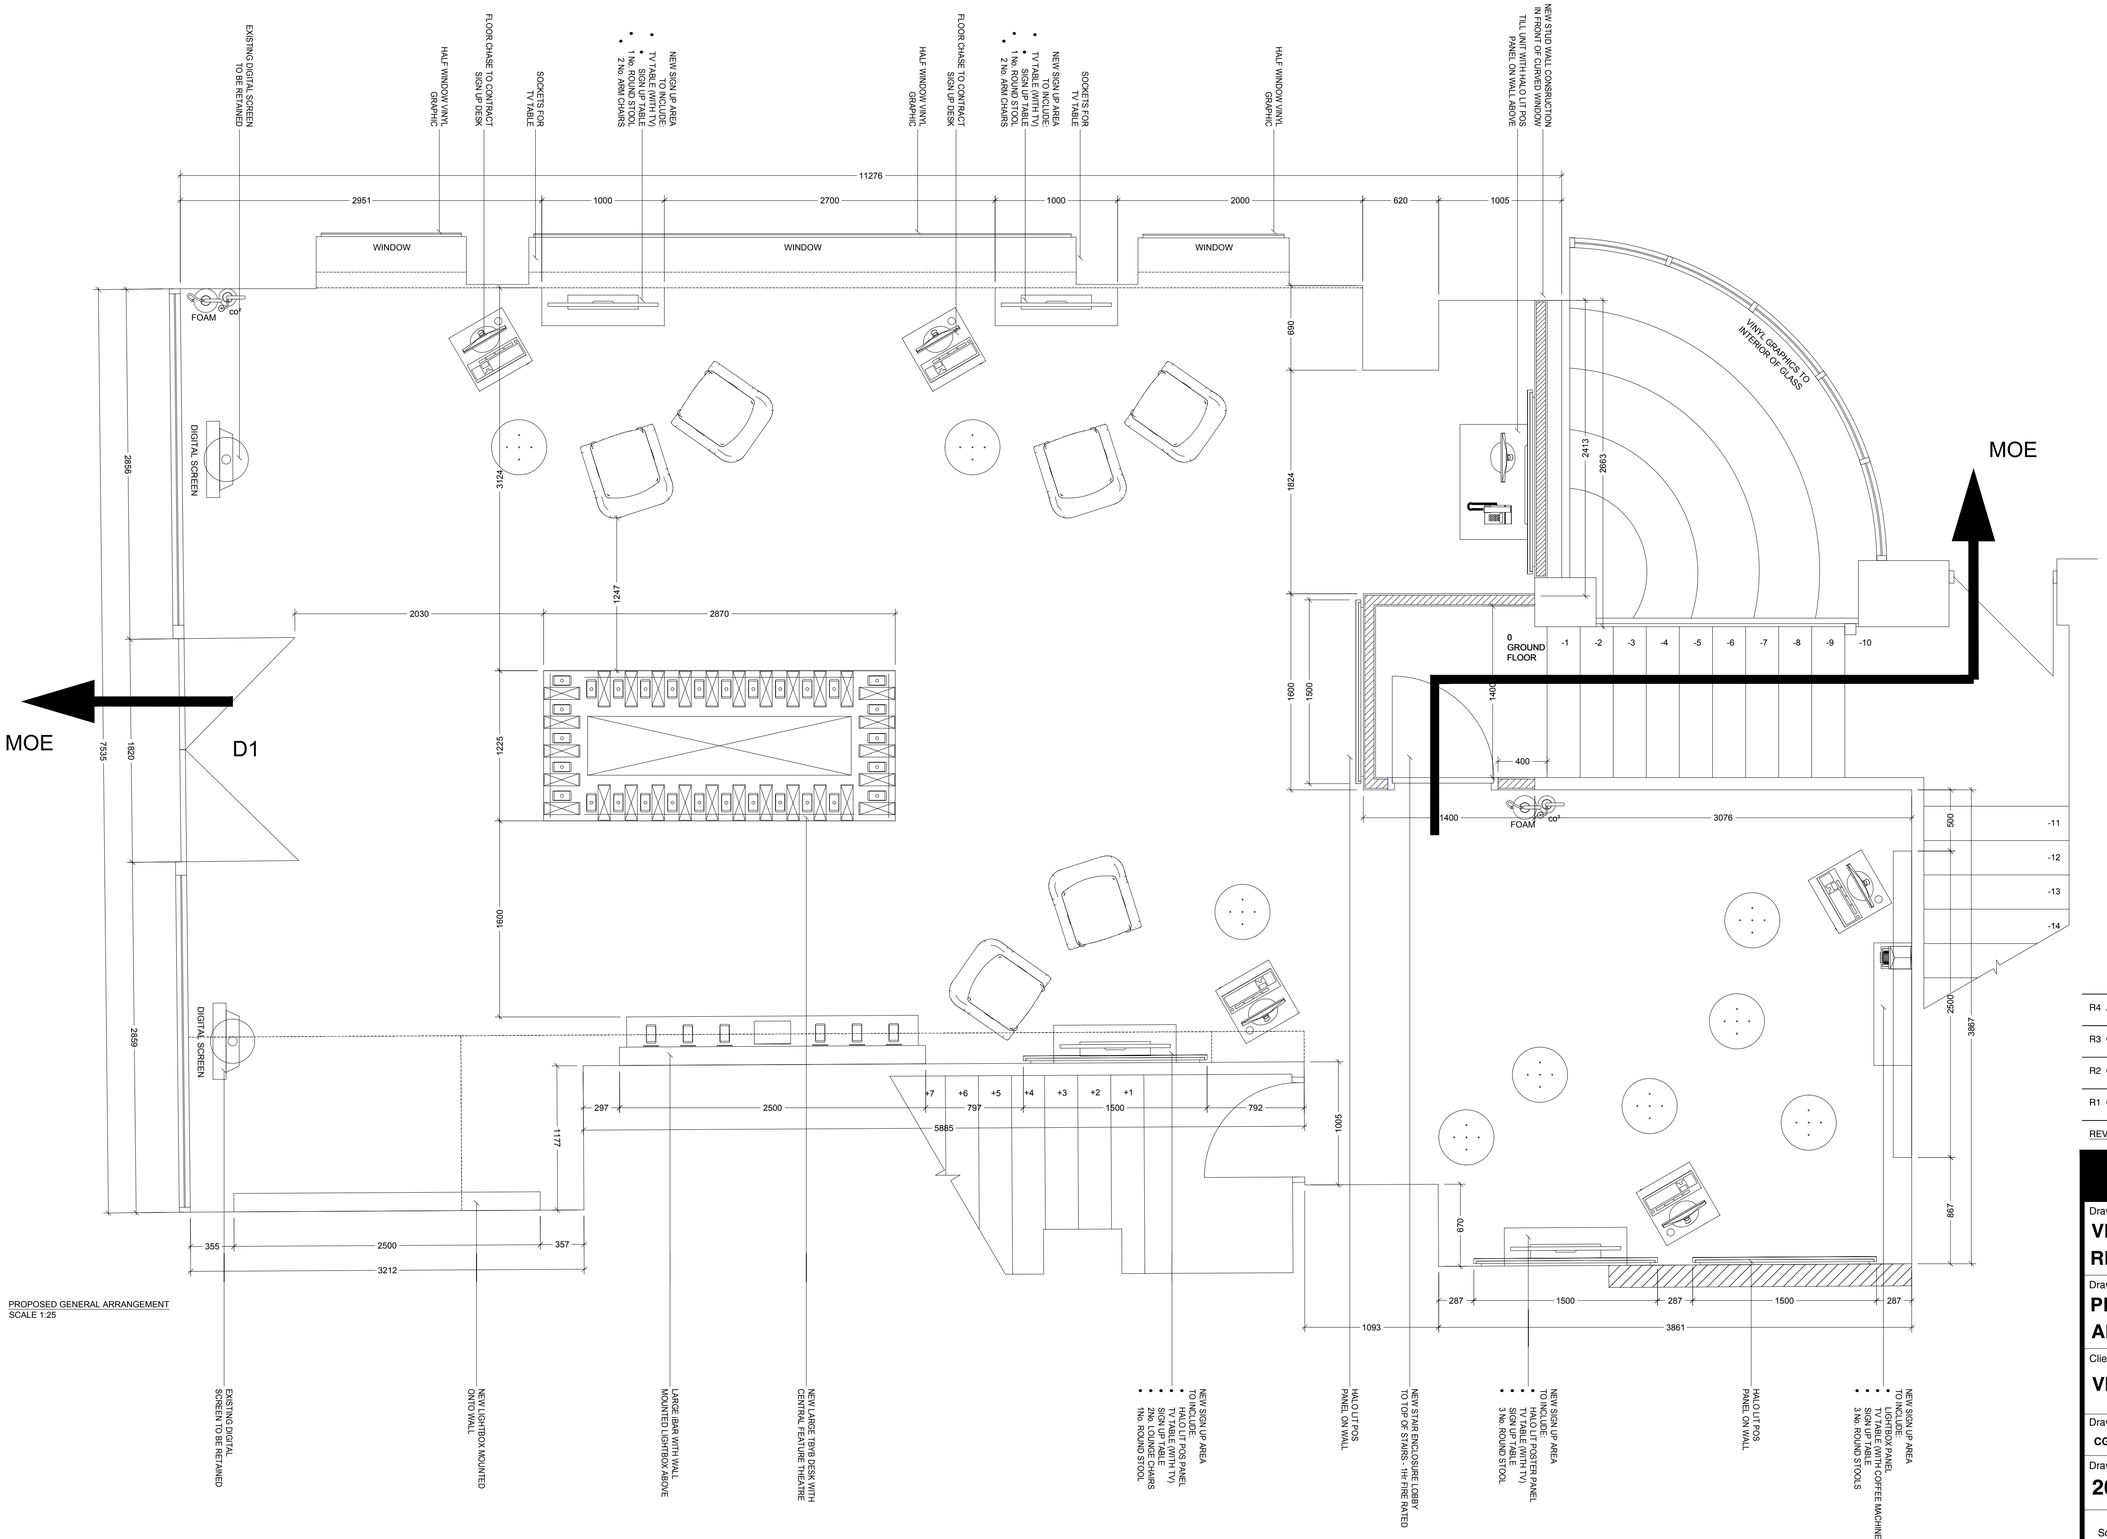

PROPOSED GENERAL ARRANGEMENT
SCALE 1:25

REVISIONS	DATE	INIT
R4 AS BUILT ISSUE	15.12.16	TM
R3 GA REVISED FOLLOWING FEEDBACK FRO VM	10.11.16	CG
R2 GA REVISED FOLLOWING FEEDBACK FRO VM	06.10.16	CG
R1 GA REVISED FOLLOWING FEEDBACK FRO VM	04.10.16	CG

Drawing project

VIRGIN MEDIA HUDDERSFIELD REFIT PROJECT

Drawing title

PROPOSED GENERAL ARRANGEMENT

Client

VIRGIN MEDIA

Drawn by	Checked by	Scale	Date
CG	-	1:25@A1	29.09.16

Drawing number

2027 - 101 - 01 - R4

Scale bar @ 1:25

0 1m 2m 2.5m

Company Registration No. 3678965. VAT Registration No. 723652246. Registered in England & Wales. Copyright of this drawing is reserved by Resolution Interiors. The drawing is issued on the condition that it is not copied, reproduced or disclosed to a third party without consent.

Lufton 2000 Business Park,Yeovil,
Somerset, BA22 8QR
Call +44 1935 422700
Fax +44 1935 422724
Email - design@resolutioninteriors.com
Website - www.resolutioninteriors.com