


Survey Control Co-ordinates				
Reference	East	North	Elevation	Description
GP501	420038.187	422374.853	124.72	Survey Station
GP503	420055.707	422387.821	126.04	Survey Station
H02	420009.164	422316.104	125.94	Survey Station
H03	420015.692	422387.829	126.07	Survey Station
H04	420021.821	422422.419	125.21	Survey Station
H05	419983.358	420412.728	125.97	Survey Station
H06	419967.111	422361.506	126.76	Survey Station
H07	419981.788	422328.516	126.49	Survey Station

Grid Orientation:
Survey related to Ordinance Survey "OSGB36" at control point GPS01
realtime correction received via Leica Geosystems "Smart Net" service.

Level Datum:
OS Orthometric Hts

Rev	Description			By	Date
Surv.	Drawn	Date	Chkd	Date	
NH	NH	15.08.16			

Martin Walsh Architectural

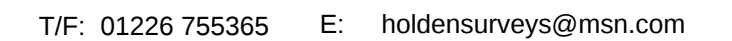

No.	Comment	Date	By
A	As-built landscaping features added	01-17	MW(JJ)

Drawing Status:

☐ Preliminary ☒ Planning Permission ☐ Building Regulation ☐ Tender ☐ Construction



Firth Buildings, 99-103 Leeds Road, Dewsbury, WF12 7BU **t** 01924 464342
e info@martinwalsh.co.uk **w** www.martinwalsh.co.uk

Job Title

Proposed Mixed Use Development (Phase 2) at Fountain Court,
Huddersfield Road, Roberttown, Liversedge WF15 7QQ

Drawing Title

Existing Site Survey

Client
Wharfedale Properties Limited

Drawn	Checked	Date	Scale	Sheet Size	Drawing No.	Rev.
NH		08/16	1:250	A1	10/K16/5991/02a	

Copyright © 2015 Martin Walsh Architectural. All Rights Reserved.
Martin Walsh Architectural is the trading name of Martin Walsh Architectural Limited. Registered in England Number 6666049