




West View - Without PV

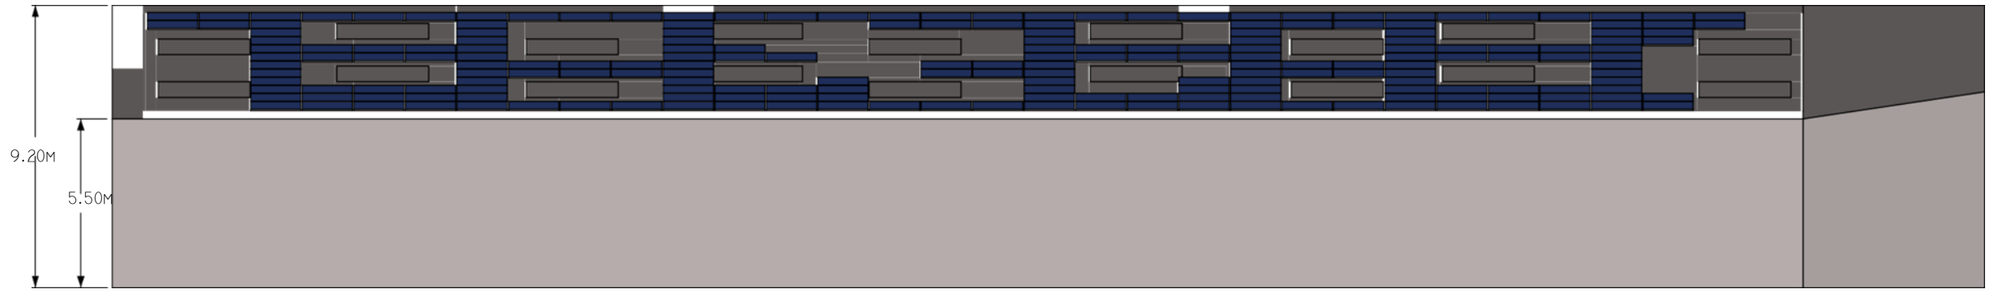

West View - With PV

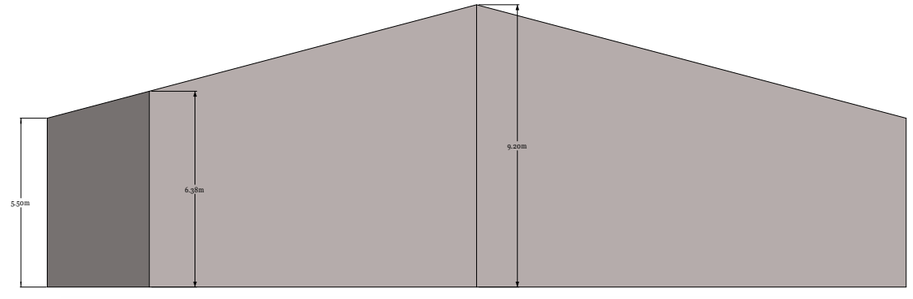

South View - Without PV

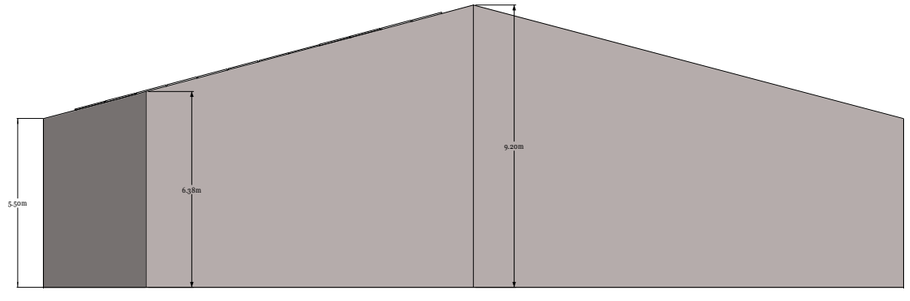

South View - With PV

soventix
Powerful Returns

Soventix GmbH
First Floor, 123 Minories
London, EC3N 1NT
PH: +44 (0) 20 3696 1170
http://www.soventix.com/

Project Name: Milnsbridge	Client: Lightsource Commercial Rooftop Ltd	Date: 12/01/2017	View: Top view	Page size: A3	
Drawing: Elevations	Soventix Reference: 4089	Revision: V1	Status: As built	Scale: 1:500	
System Details: Size: 50 kWp Mounting: Roof parallel PV Panels: 200x 250W Poly	Site Address: Colne Vale Road, Milnsbridge, Huddersfield, HD3 4NY OS Reference: SE 11203 15787	Comments/Observations:		Drawn by: FS	Checked and approved by: FS