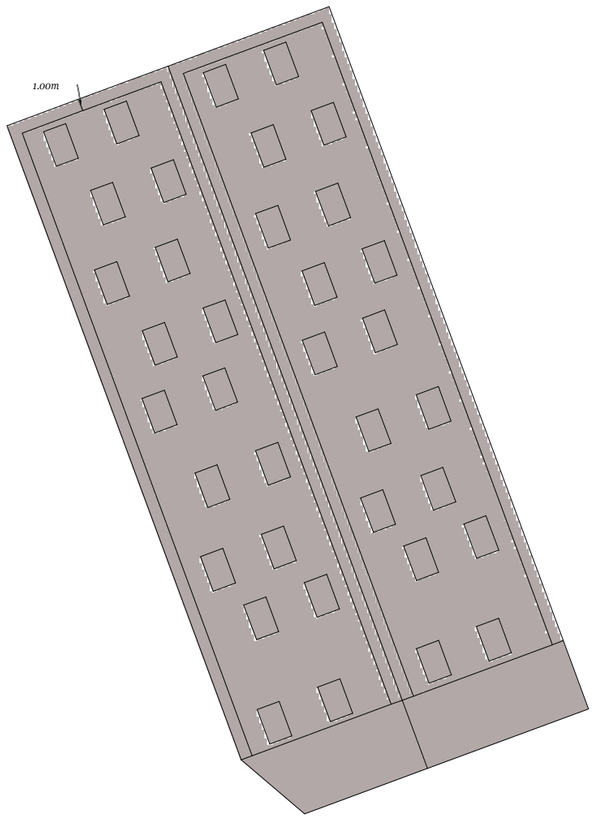

WITHOUT PV

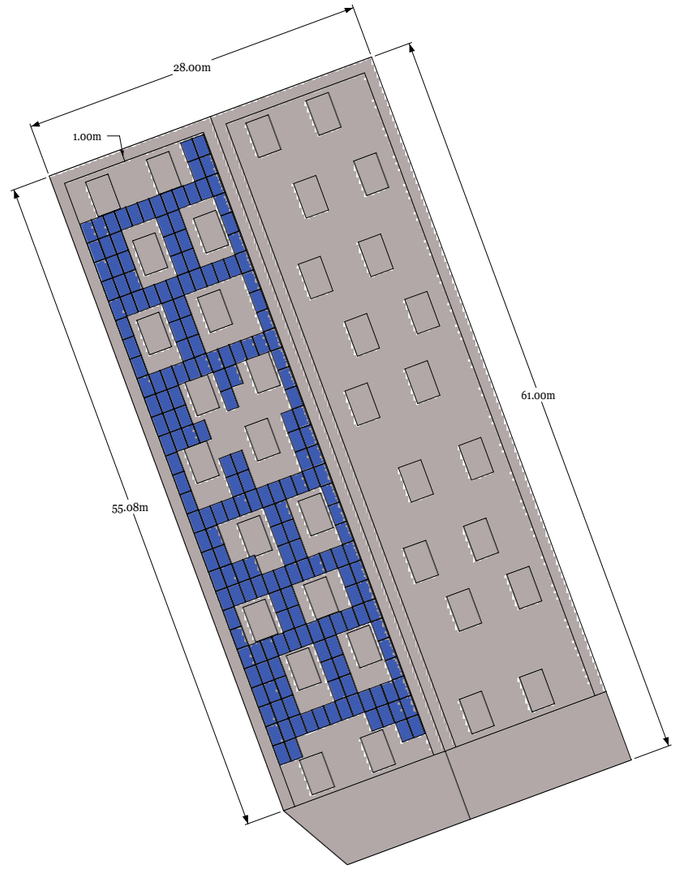

WITH PV

TOTAL USED ROOF AREA: 627.47 m^2
MODULE AREA: 325 m^2

soventix
Powerful Returns

SOVENTIX GMBH
FIRST FLOOR, 123 MINORIES
LONDON, EC3N 1NT
PH: +44 (0) 20 3696 1170
HTTP://WWW.SOVENTIX.COM/

PROJECT NAME: MILNSBRIDGE	CLIENT: LIGHTSOURCE COMMERCIAL ROOFTOP LTD	DATE: 12/01/2017	VIEW: TOP VIEW	PAGE SIZE: A3	N
DRAWING: TOP VIEW	SOVENTIX REFERENCE: 4089	REVISION: V1	STATUS: AS BUILT	SCALE: 1:500	
SYSTEM DETAILS: SIZE: 50 KWP MOUNTING: ROOF PARALLEL PV PANELS: 200X 250W POLY	SITE ADDRESS: COLNE VALE ROAD, MILNSBRIDGE, HUDDERSFIELD, HD3 4NY OS REFERENCE: SE 11203 15787	COMMENTS/OBSERVATIONS:		DRAWN BY: FS	CHECKED AND APPROVED BY: FS