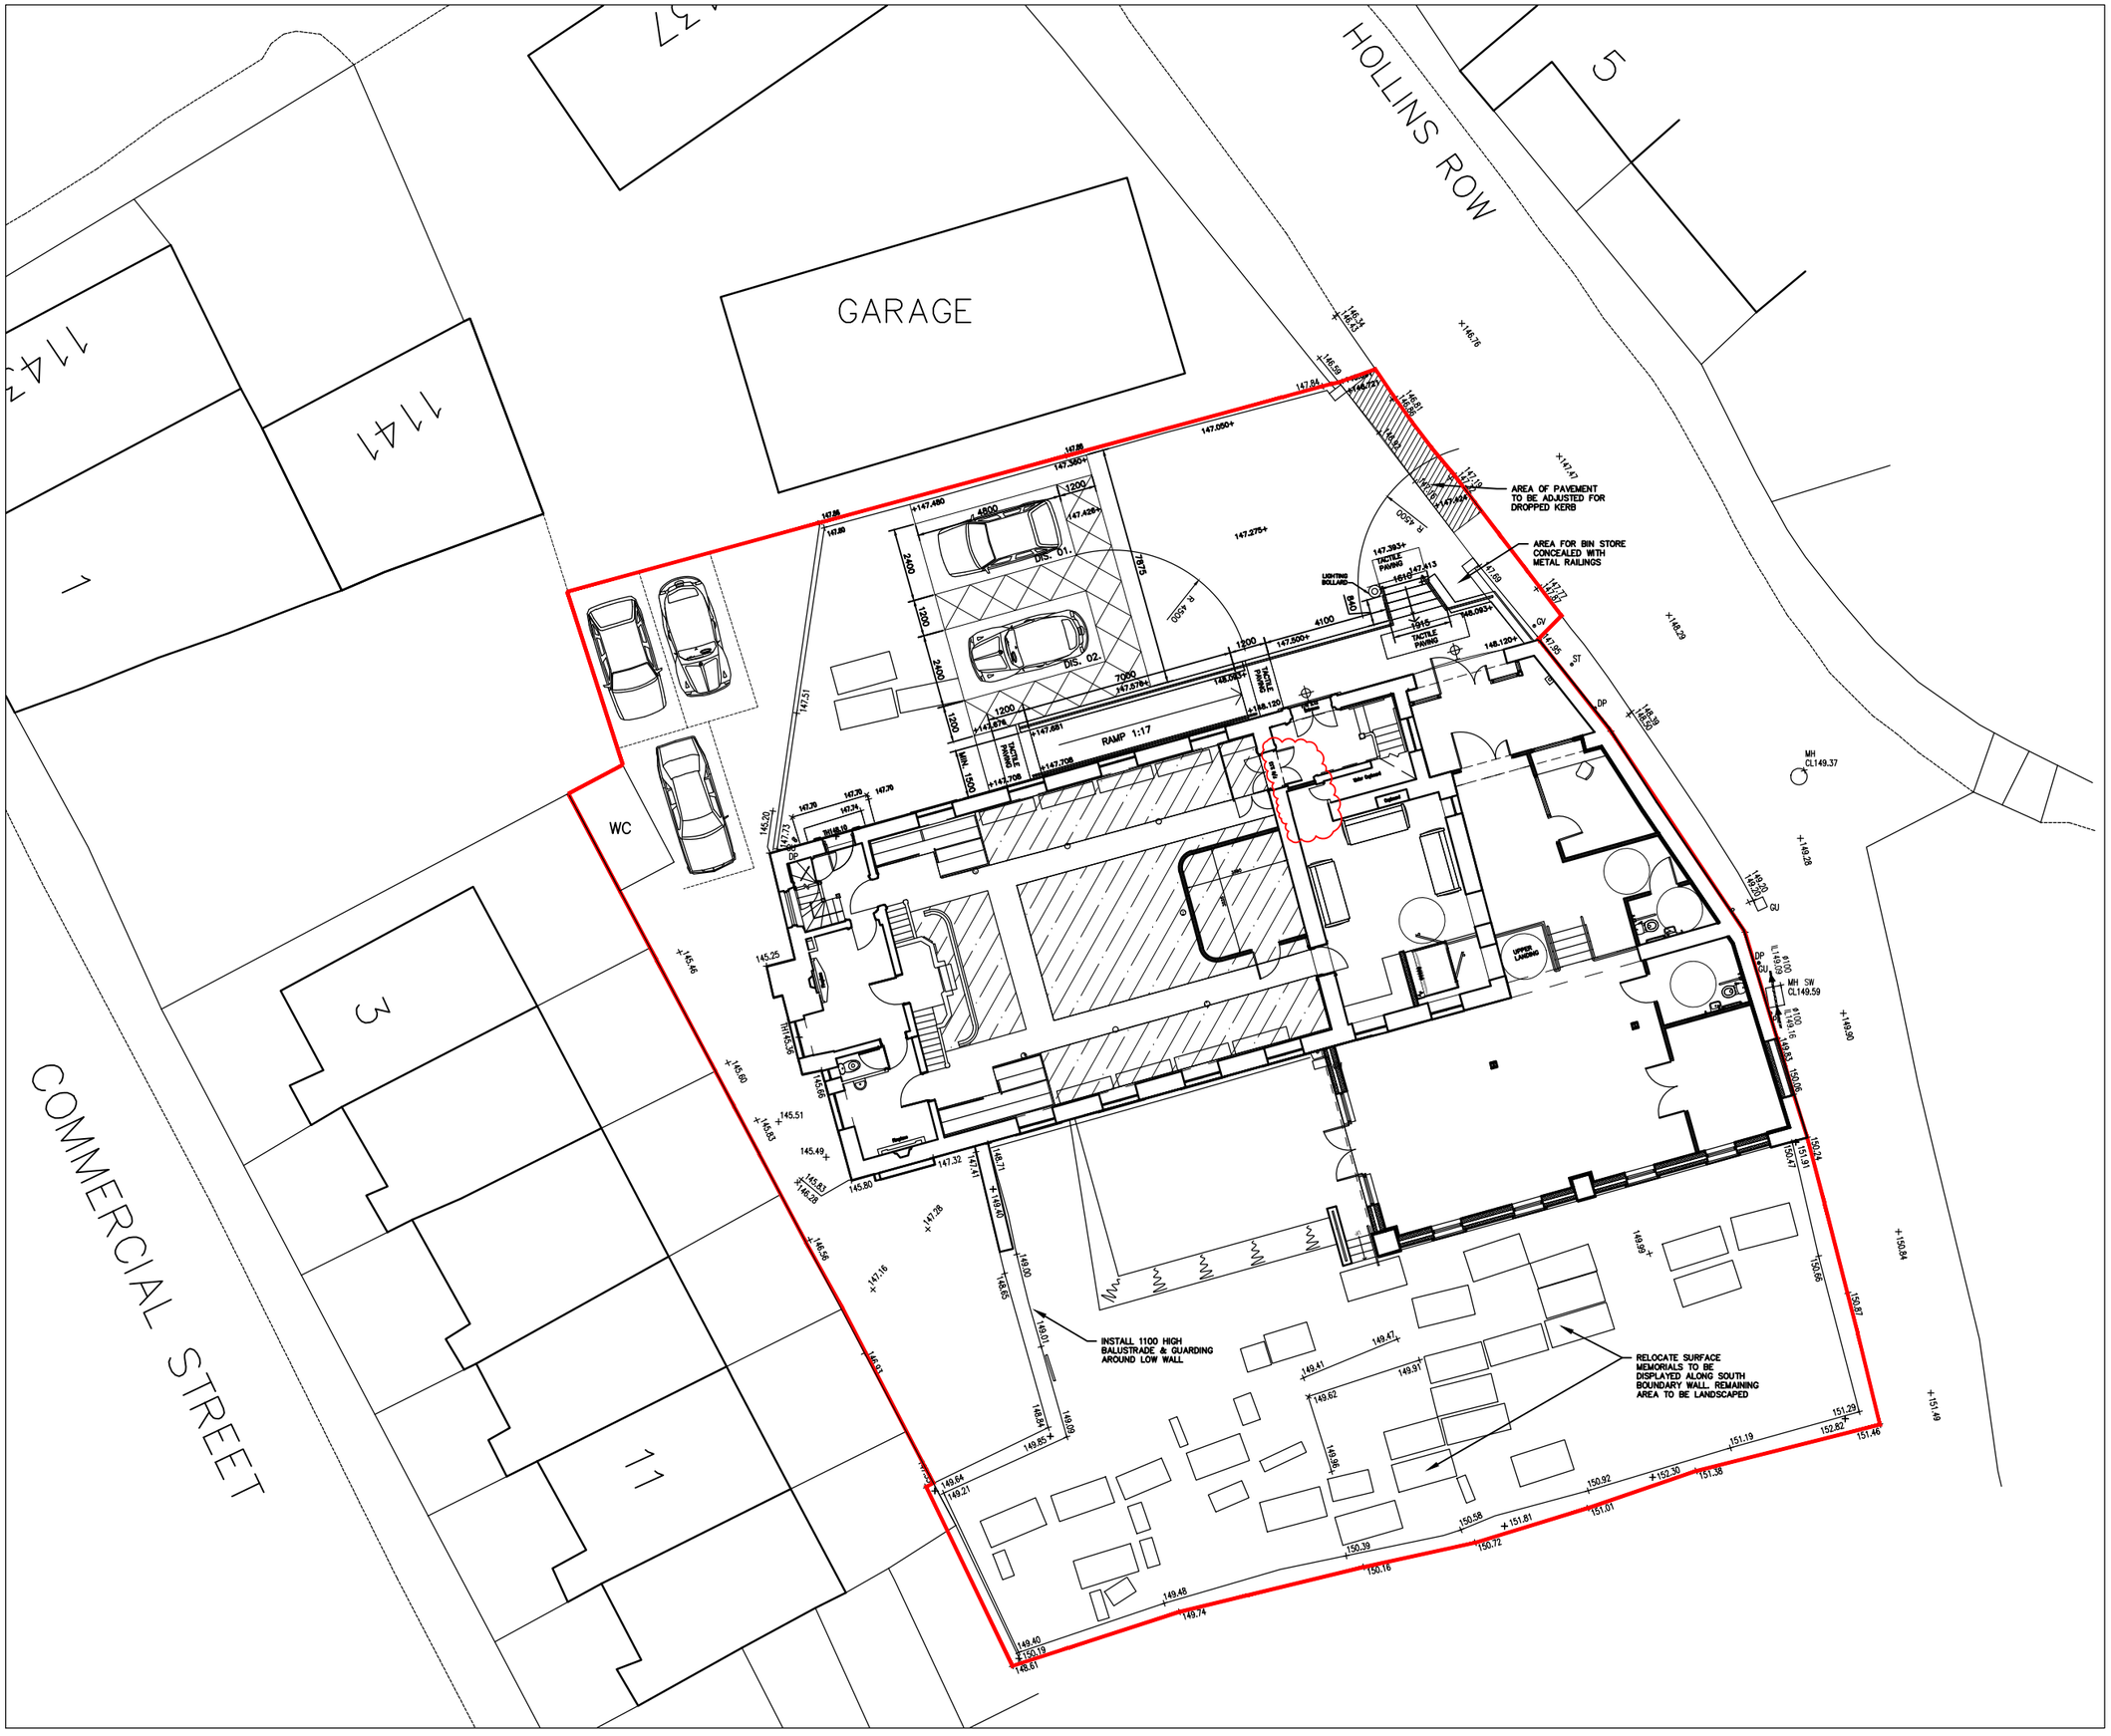

Notes.

- All dimensions to be checked on site.
- No dimensions to be scaled from this drawing unless otherwise stated.

Revision No.	Date		Checked By	Revision By
H	09.19	FLOOR PLAN UPDATED.		SLW
G	06.19	DIMENSIONS ADDED TO EXTERNAL RAMP AND STEPS.		SLW
F	04.19	ISSUED TO BUILDING CONTROL		SLW
E	11.18	PARKING ADJUSTED TO LOWER SITE TO SHOW EX. WC CONCEALED ENTRANCE DOOR ADDED, BALUSTRADE TO GARDEN ADDED		IWL
D	9.18	RED LINE SITE BOUNDARY EXTENDED TO ALLOW FOR VEHICLE CROSSING		IWL
C	8.18	SITE RED LINE ADDED. SCALE AMENDED TO 1:200 W.C HAS LIFTEDED ADDED TO ACCESS REAR ACTIVITY AREA.		IWL
B	7.18	THIRD CAR ADDED TO REAR LOWER PARKING AREA		IWL
A	7.18	ADDITIONAL PARKING SHOWN TO WEST END		IWL

BYROM CLARK ROBERTS
ARCHITECTS / SURVEYORS / ENGINEERS
MacLaren House | Talbot Road | Old Trafford | Manchester | M32 0FP
0161 875 0500 | manchester@bcrnet.eu | www.byromclarkroberts.com
First Floor | Swan House | Russell Street| Chester | CH3 5AL
01244 348849 | chester@bcrnet.eu | www.byromclarkroberts.com
Unit 2 (Millwright) | 49 Byron Street | Leeds | LS2 7NA
0113 388 8000 | leeds@bcrnet.eu | www.byromclarkroberts.com

Client.
SHABANG INCLUSIVE LEARNING LTD
SLAITHWAITE

Project.
FORMER PROVIDENCE BAPTIST CHAPEL CONVERSION WORKS

Drawing Title.
SITE LAYOUT AS PROPOSED

Scale.	Date.	Drawn.	Check.
1:200 @A3	4.18	SLW	IWL

Job No.	Drawing No.	Rev.
5117/0953	10	H