



- GARAGE TO BE EXTENDED AT THE FRONT BY 1500mm
- DOUBLE DOORS TO BE REPLACED BY A SINGLE DOOR

PROPOSED FRONT ELEVATION SHOWN IN RED. DOUBLE DOORS TO BE REPLACED WITH A SINGLE DOOR. NEW FRONTAGE SAME AS ORIGINAL FOR REST OF MASONRY WORK


(1:100)

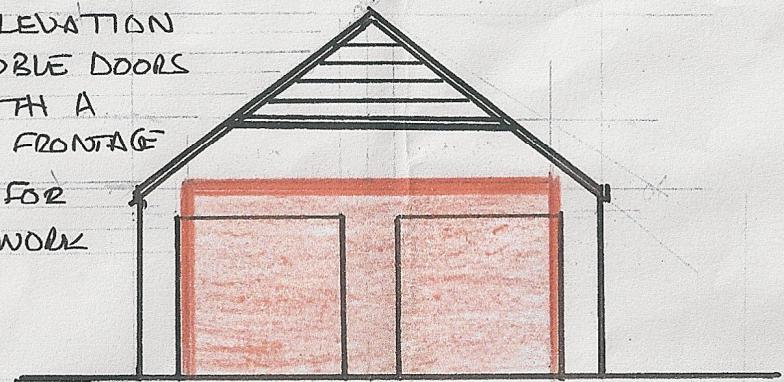



THIS IS ONLY WALL TO BE TAKEN DOWN (GARAGE FRONT WALL) AND THEN BE BUILT 1500mm FORWARD

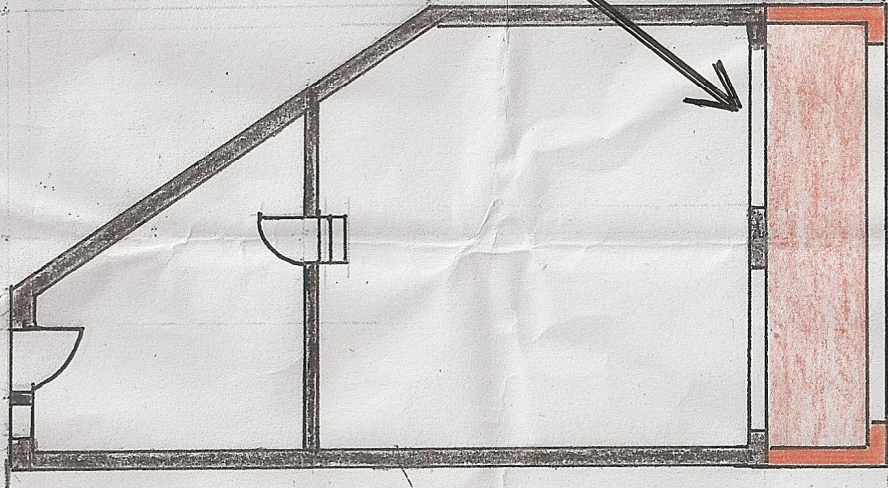

PROPOSED GARAGE FLOOR EXTENSION SHOWN IN RED (1:100)

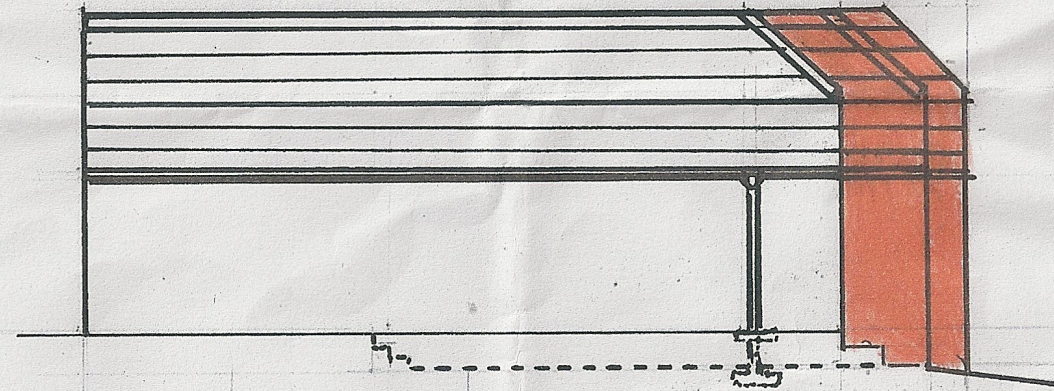

PROPOSED SIDE ELEVATION EXTENSION SHOWN IN RED (1:100)

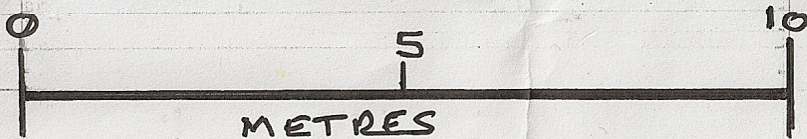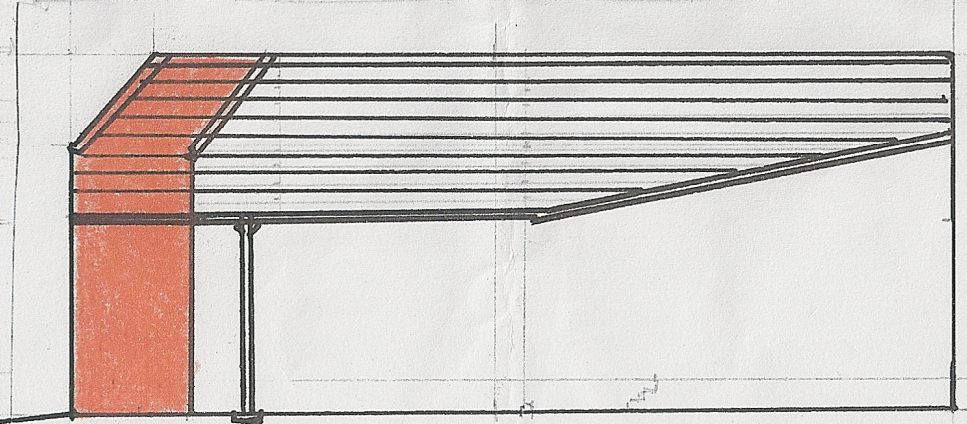

SCALE 1:100