


## AS-INSTALLED FRONT ELEVATION

Scale 1:50

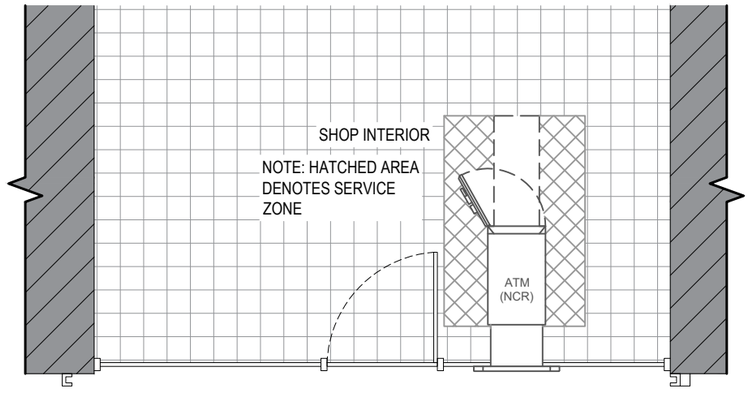


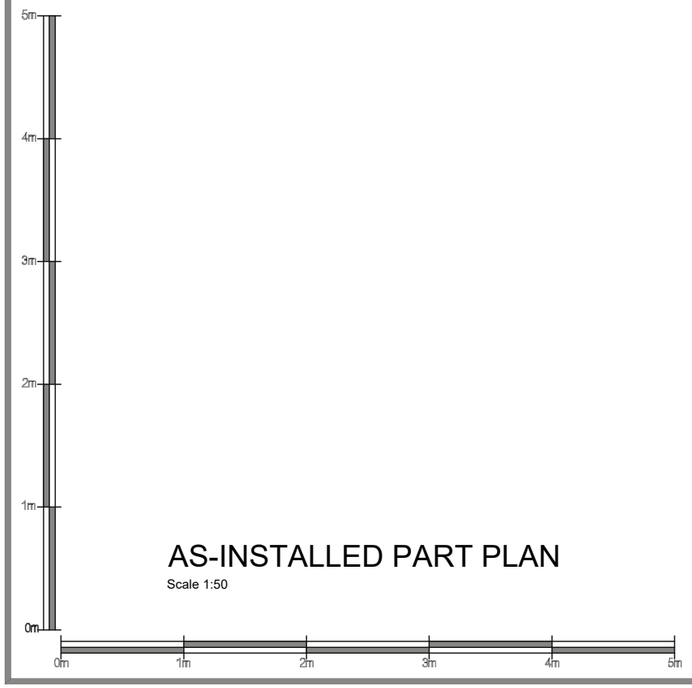


## AS-INSTALLED PART PLAN

Scale 1:50

NM GROUP

| Date: | Comments: | By: |
|---|---|---|
| | | |

GENERAL NOTES:

1) All dimensions in millimeters unless otherwise stated.

Site:
Milnsbridge News,
69 Market Street,
Huddersfield,
HD3 4HZ

Drawing Title:

As-Installed Plan and Elevation

| Ref: | Date: | Rev: |
|---|---|---|
| T019409_AI | 08/10/2019 | |
| Scale: 1:50 | Paper: A3 | Date Rev: |