



Existing boundary properties and soft landscaping



Existing boundary properties



Existing boundary property and Park landscaping




Existing boundary property and Park landscaping



Existing stone boundary wall and existing boundary properties



View to external yard from main road, Existing stone boundary wall.

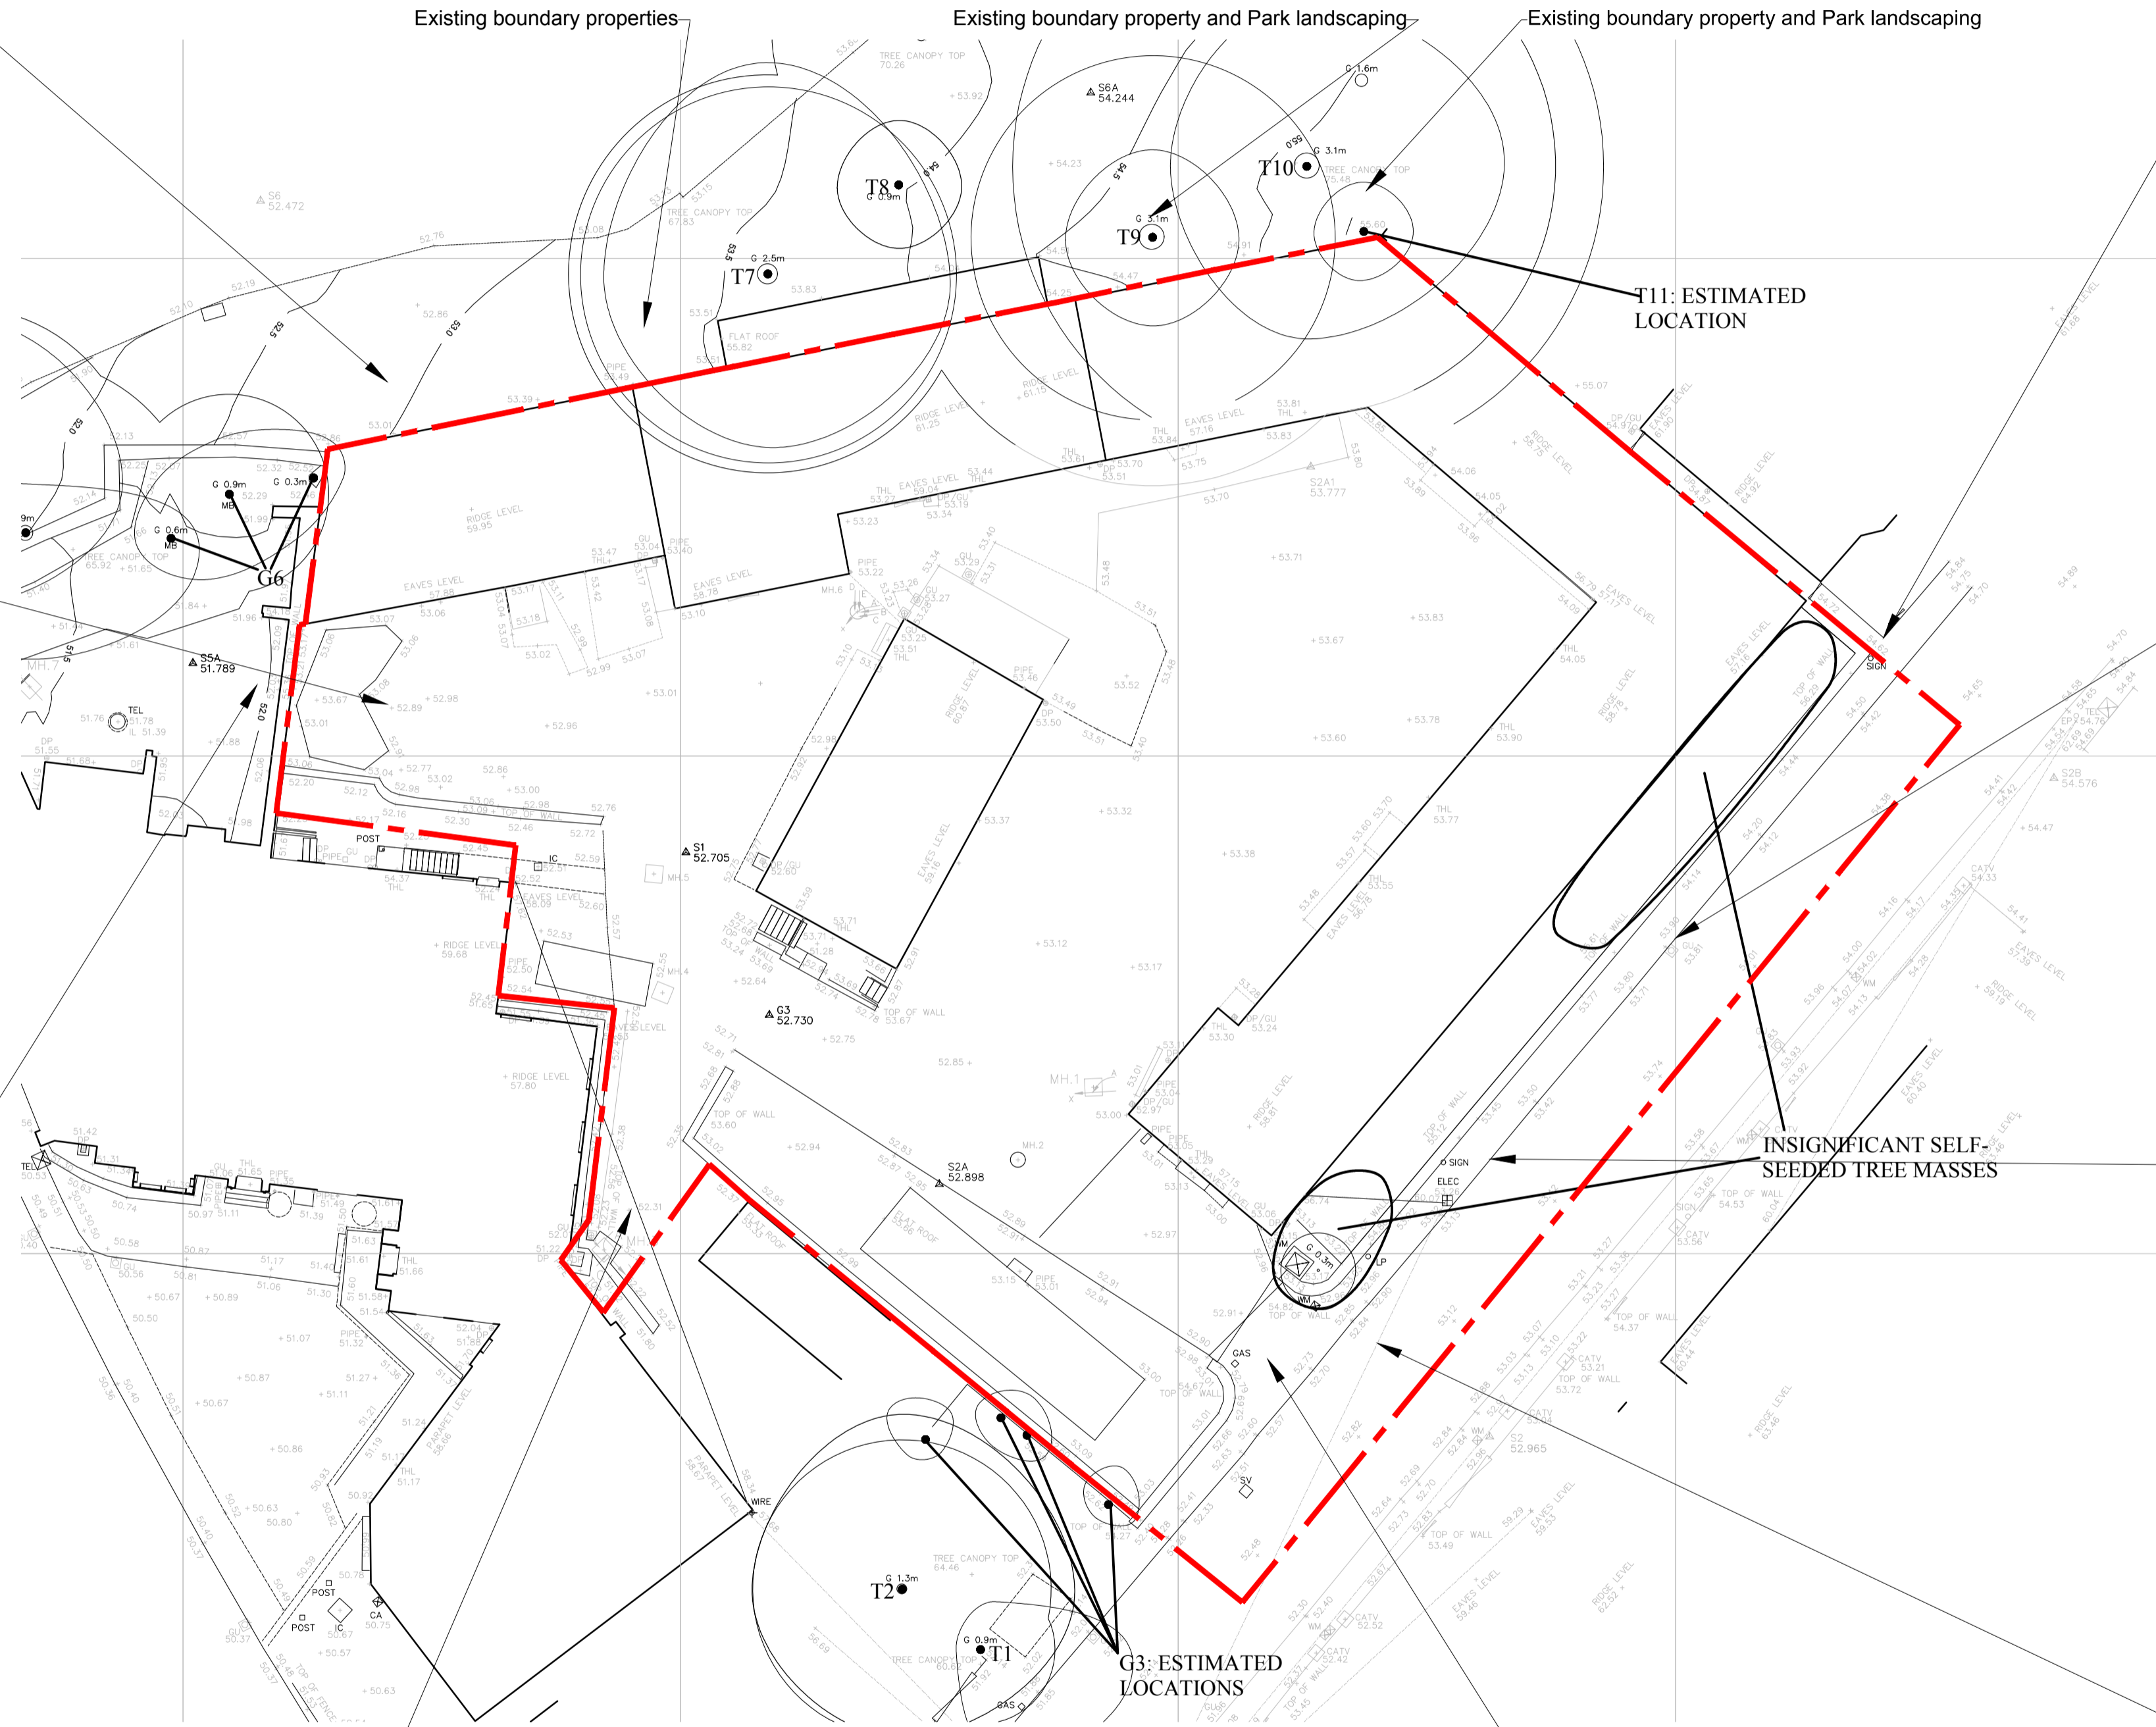

Edge of site boundary St Paul's Road. Stone wall and large mature vegetation.



St Paul's Road existing tall stone wall.



St Paul's Road top of existing stone wall, overgrown vegetation and external building wall.



Existing brick boundary wall



Existing Stone entrance wall and metal railings



Existing Site Entrance and stone wall St Paul's Road

REV: A DATE: 05/12/19 DRAWN: AH CHECKED: MH  
Red line site boundary amended following councils confirmation.

REVISIONS

This design is copyright ©



Proposed Older Persons Residential Development  
St Pauls Road, Mirfield

Existing Site Boundary treatment

Drawn: TC Date: 26/09/19 Scale: 1:100@A1 Checked: AH



Dwg No: 501/01(02)003 A