
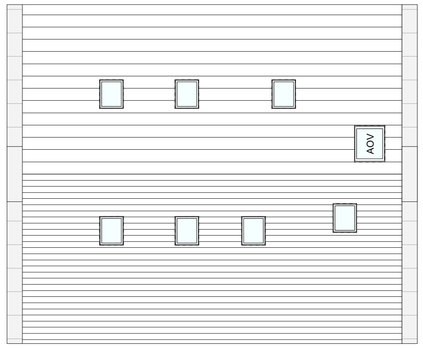



Roof Plan As Proposed
Scale 1:100

0m 1m 2m 3m 4m 5m

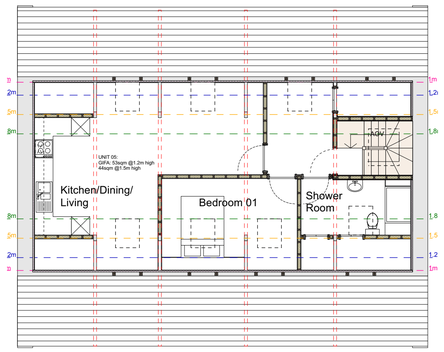


Second Floor As Proposed
Scale 1:100

0m 1m 2m 3m 4m 5m

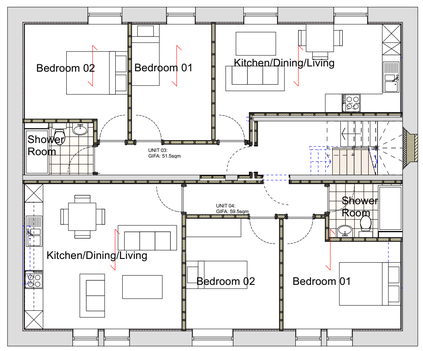

First Floor As Proposed
Scale 1:100

0m 1m 2m 3m 4m 5m

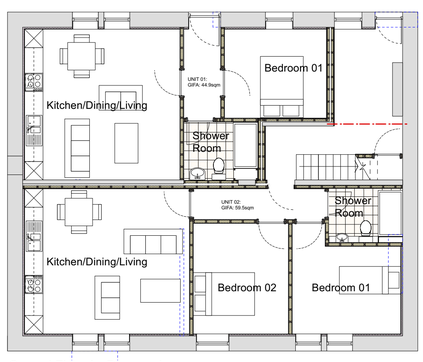

Ground Floor As Proposed
Scale 1:100


0m 1m 2m 3m 4m 5m




Rear Elevation As Proposed
Scale 1:100




Front Elevation As Proposed
Scale 1:100

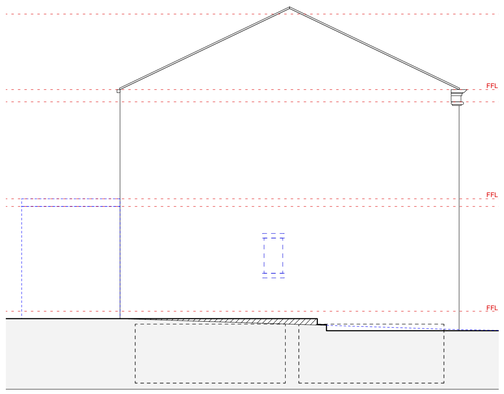


Side Elevation As Proposed
Scale 1:100

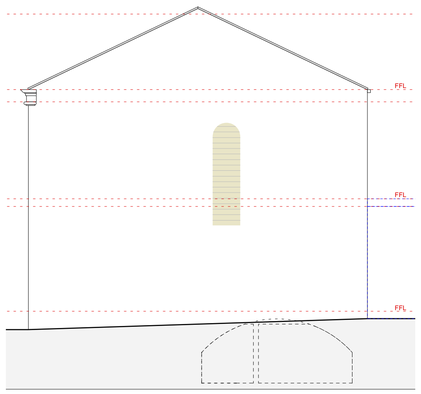

Side Elevation As Proposed
Scale 1:100

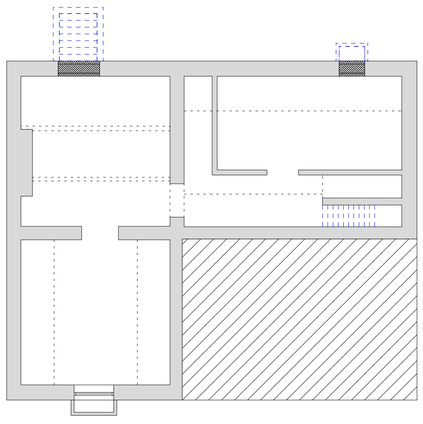

Basement No Change
Scale 1:100

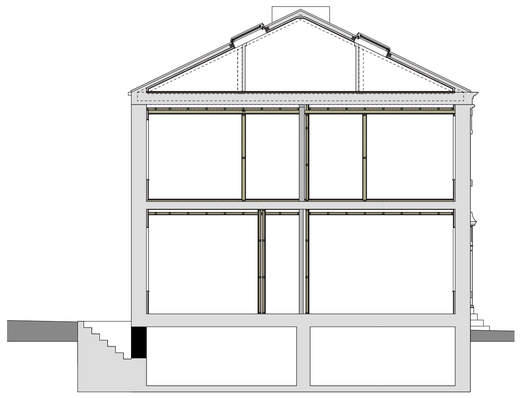

Typical Section As Proposed
Scale 1:100

0m 1m 2m 3m 4m 5m

NOTES:

Any errors or omissions to be reported to Code L6 immediately.

This drawing and design is the copyright of Code L6 and is not to be used for any purpose without their consent.

AS PROPOSED/ AS BUILT

rev	details	date

Code L6
Architecture Ltd

31 Halifax Road Brighouse
West Yorkshire HD6 2AA
T: 01484 714 870
E: codeL6@btinternet.com
W: www.CODEL6.com

Project:
12 Calder Road,
Mirfield,1
WF14 8PJ

Client:
John Oates Homes

Drawing:
Plans and Elevations
As Proposed/

Date:	Scale:	Size:
14/05/21	1:100	A1

Drawing Number:
19-119-110