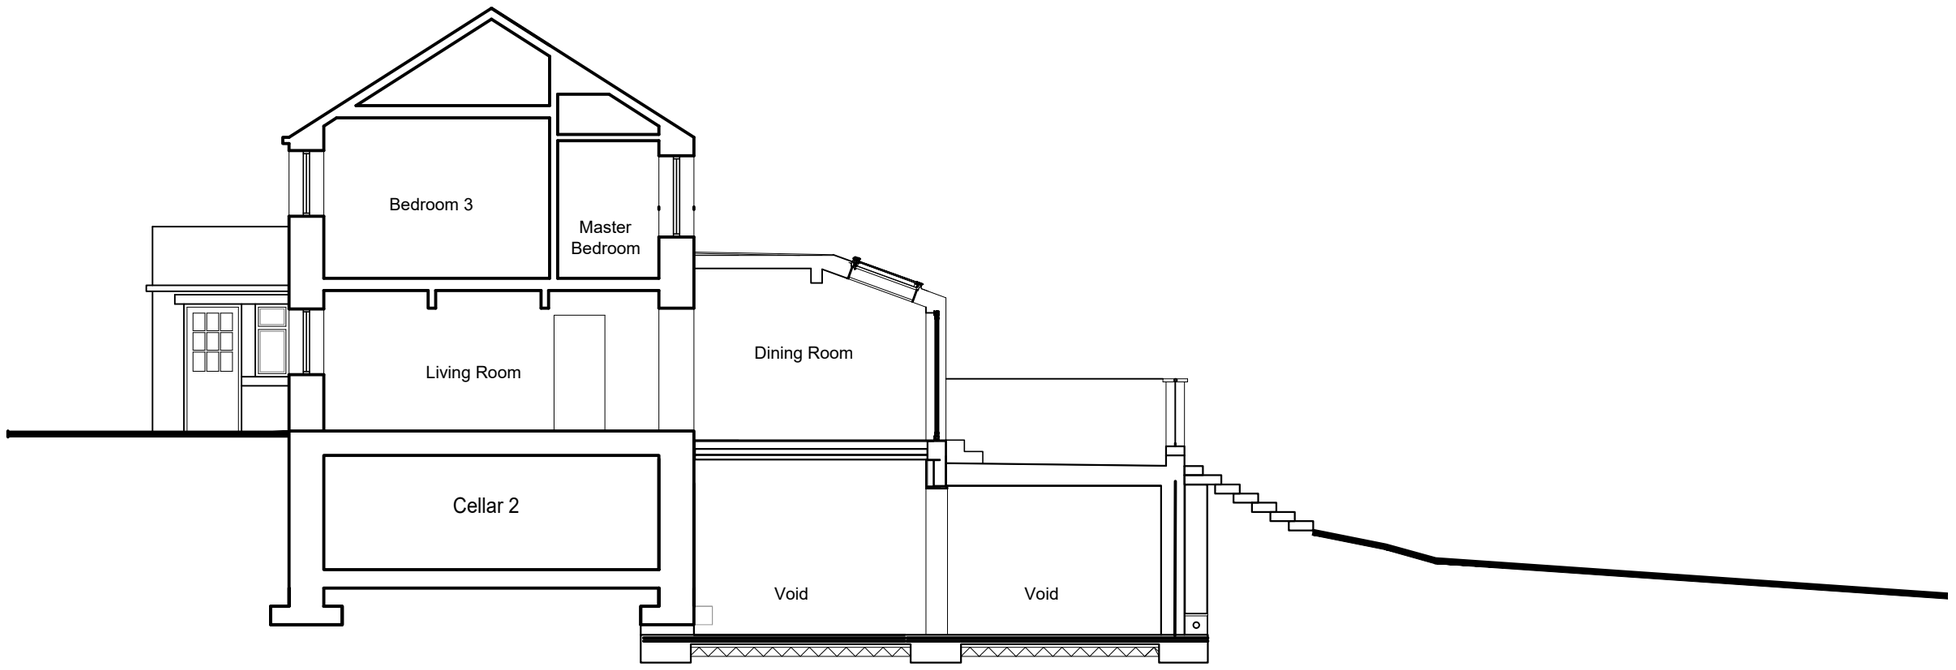


SECTION A-A AS BUILT

Only figured dimensions should be used.

Scaled dimensions should be checked with the Architect.

This drawing together with the design, is the property and copyright of the Architect and must not be reproduced without written permission

DO NOT SCALE OFF THIS DRAWING

rev	description	drwn	auth	date

ACUMEN
DESIGNERS & ARCHITECTS

acumenarchitects.co.uk 01484 546 000
Headrow House, Old Leeds Road, Huddersfield, HD1 1SG

Client
MR & MRS GIBSON

Project
CORNMILL COTTAGE
SHELLEY, HUDDERSFIELD

Project No	Drawing No	Rev
2495	(100)72	/

Description
SECTION A-A
AS BUILT

Scale	Date Drawn	Drawn By	Authorised By
1:100@ A3	AUG'21	JF	JC

File loc: Z:\Active Projects\ACTIVE PROJECTS\2495 - Mr S Gibson - Cornmill Cottage\2021 Pre Application Enquiry\[2495] Cornmill cottage Pre application Enquiry

Purpose of Issue
Planning ● Building Regs ○ Tender ○ Construction ○ Comment ○ Info ○