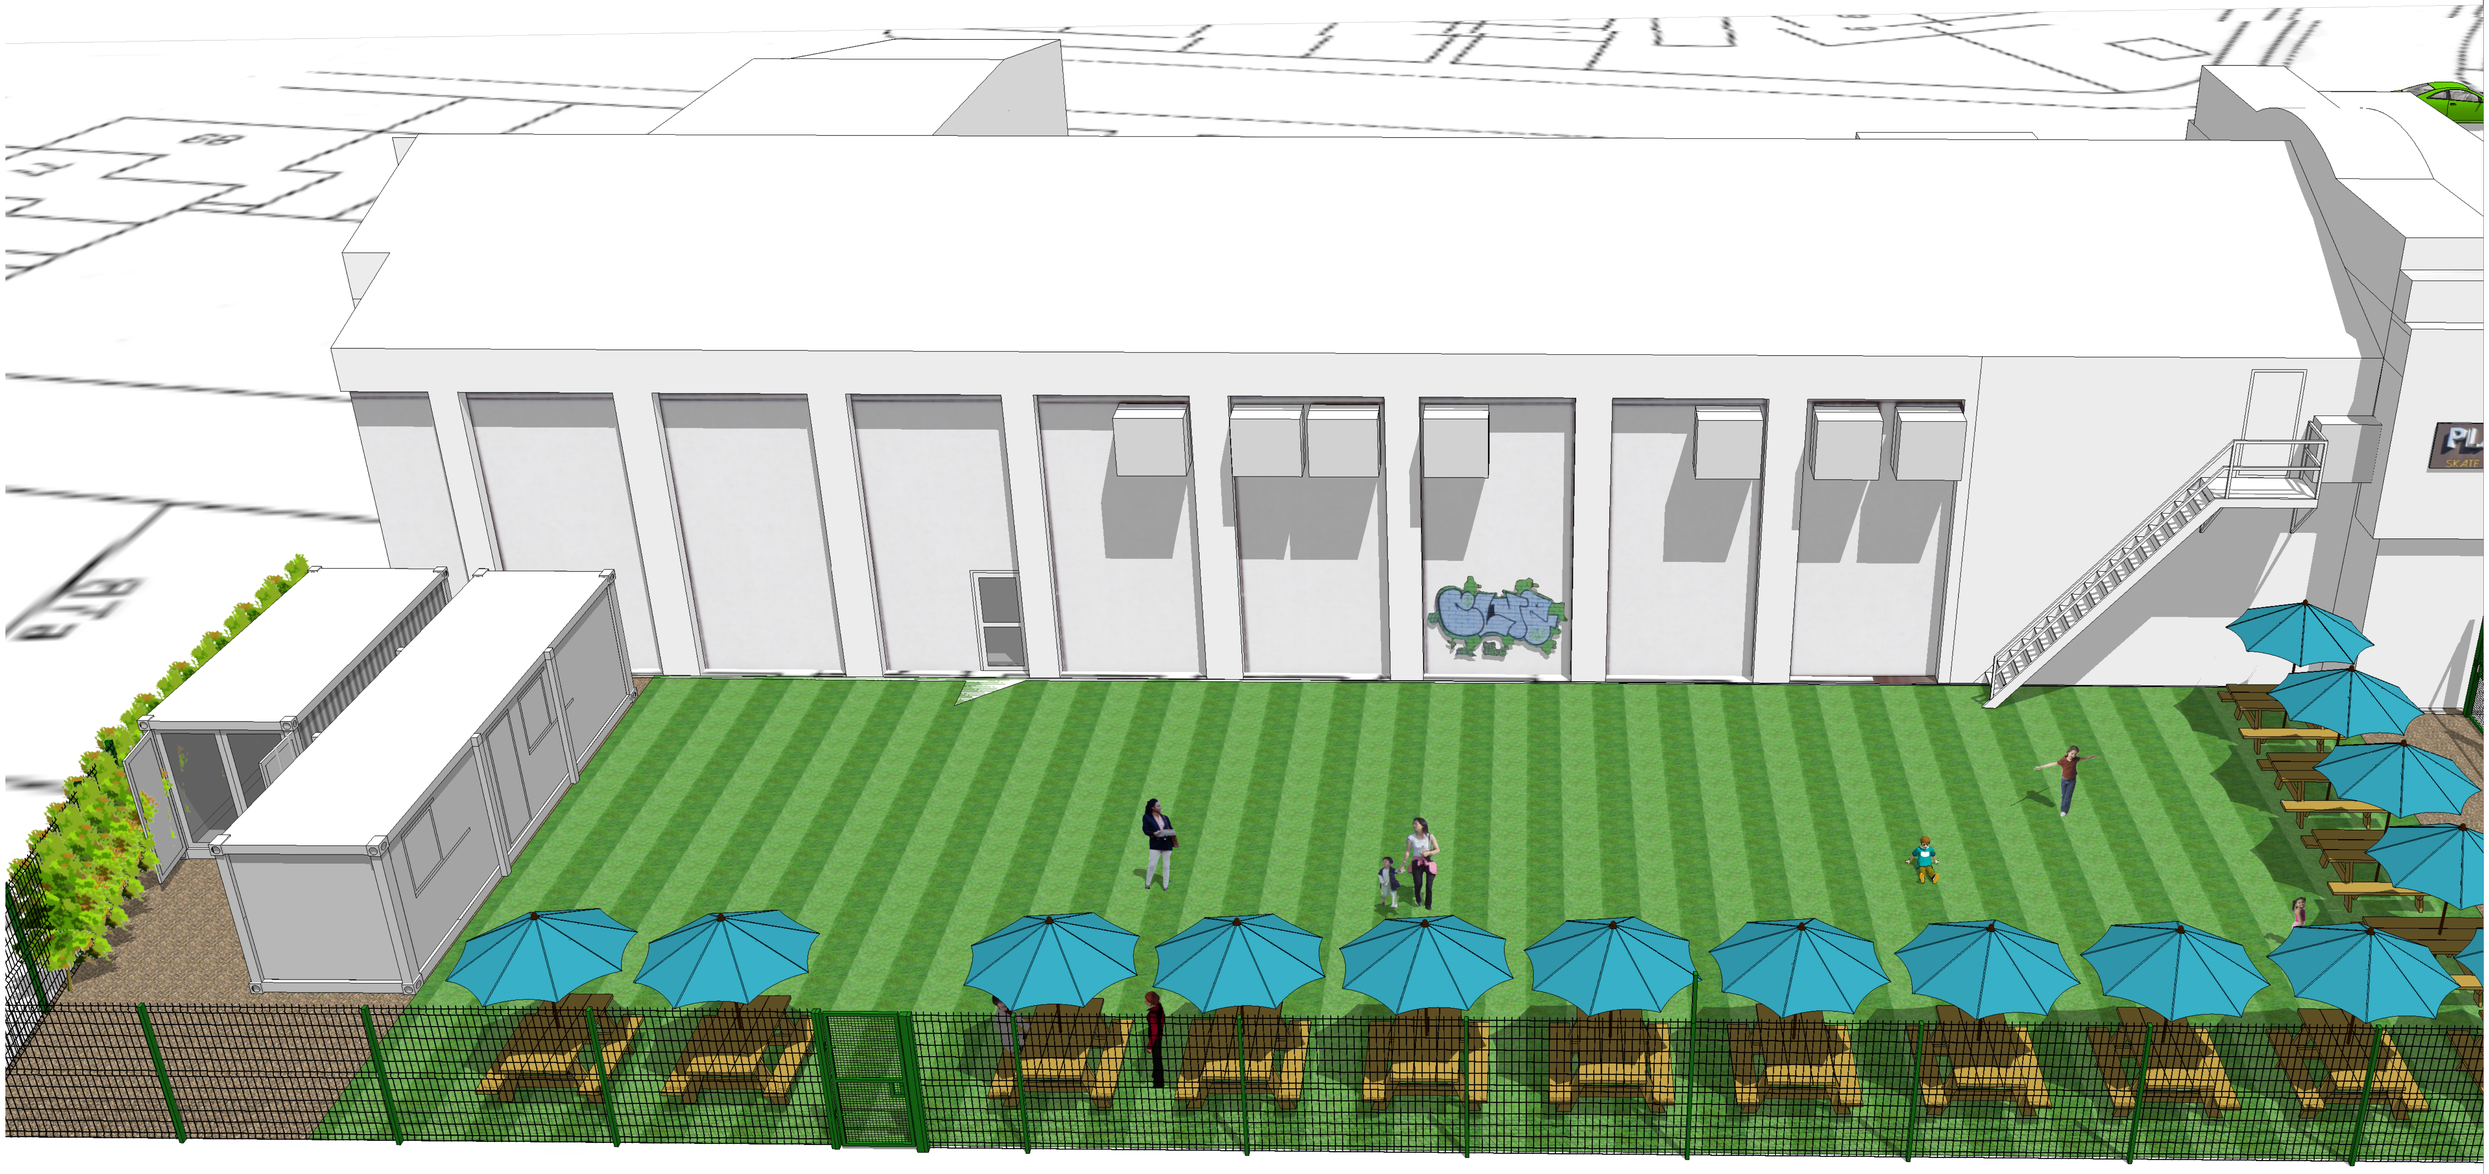


Jade3 Architecture Ltd

Jade3 Architecture Ltd, Studio 12, Silver Street, Wakefield WF1 1UY
Cellphone . 07535 740097 www.jade3architecture.co.uk

Playworld
land at rear of 140, Westbourne Road
Marsh
Huddersfield

Project No.	Project Title
2022 Enquiry 39	**as built view 1 of paladin fencing and vehcular gate fitted with plants and leaves advertisement panels with corner advertisement board and art painting on side facade**

Drawn By	Reviewed By	Scale	Date
	MC	**n/a @A1 size**	**20/08/2022**

Drawn No.	Reviewed Title	Revision
105		

Important Notice
Do not scale off this drawing. Critical dimensions should be checked on site prior to works commencing. Dimensional conflicts should be brought to the company's attention as soon as they become apparent. Failure to do so could render the contractor liable for subsequent losses. Copyright in this drawing and any work executed from this drawing remians the property of Jade3 Architecture Ltd.

© Copyright Jade3 Architecture Ltd.