


Maps by email Plant Information Reply

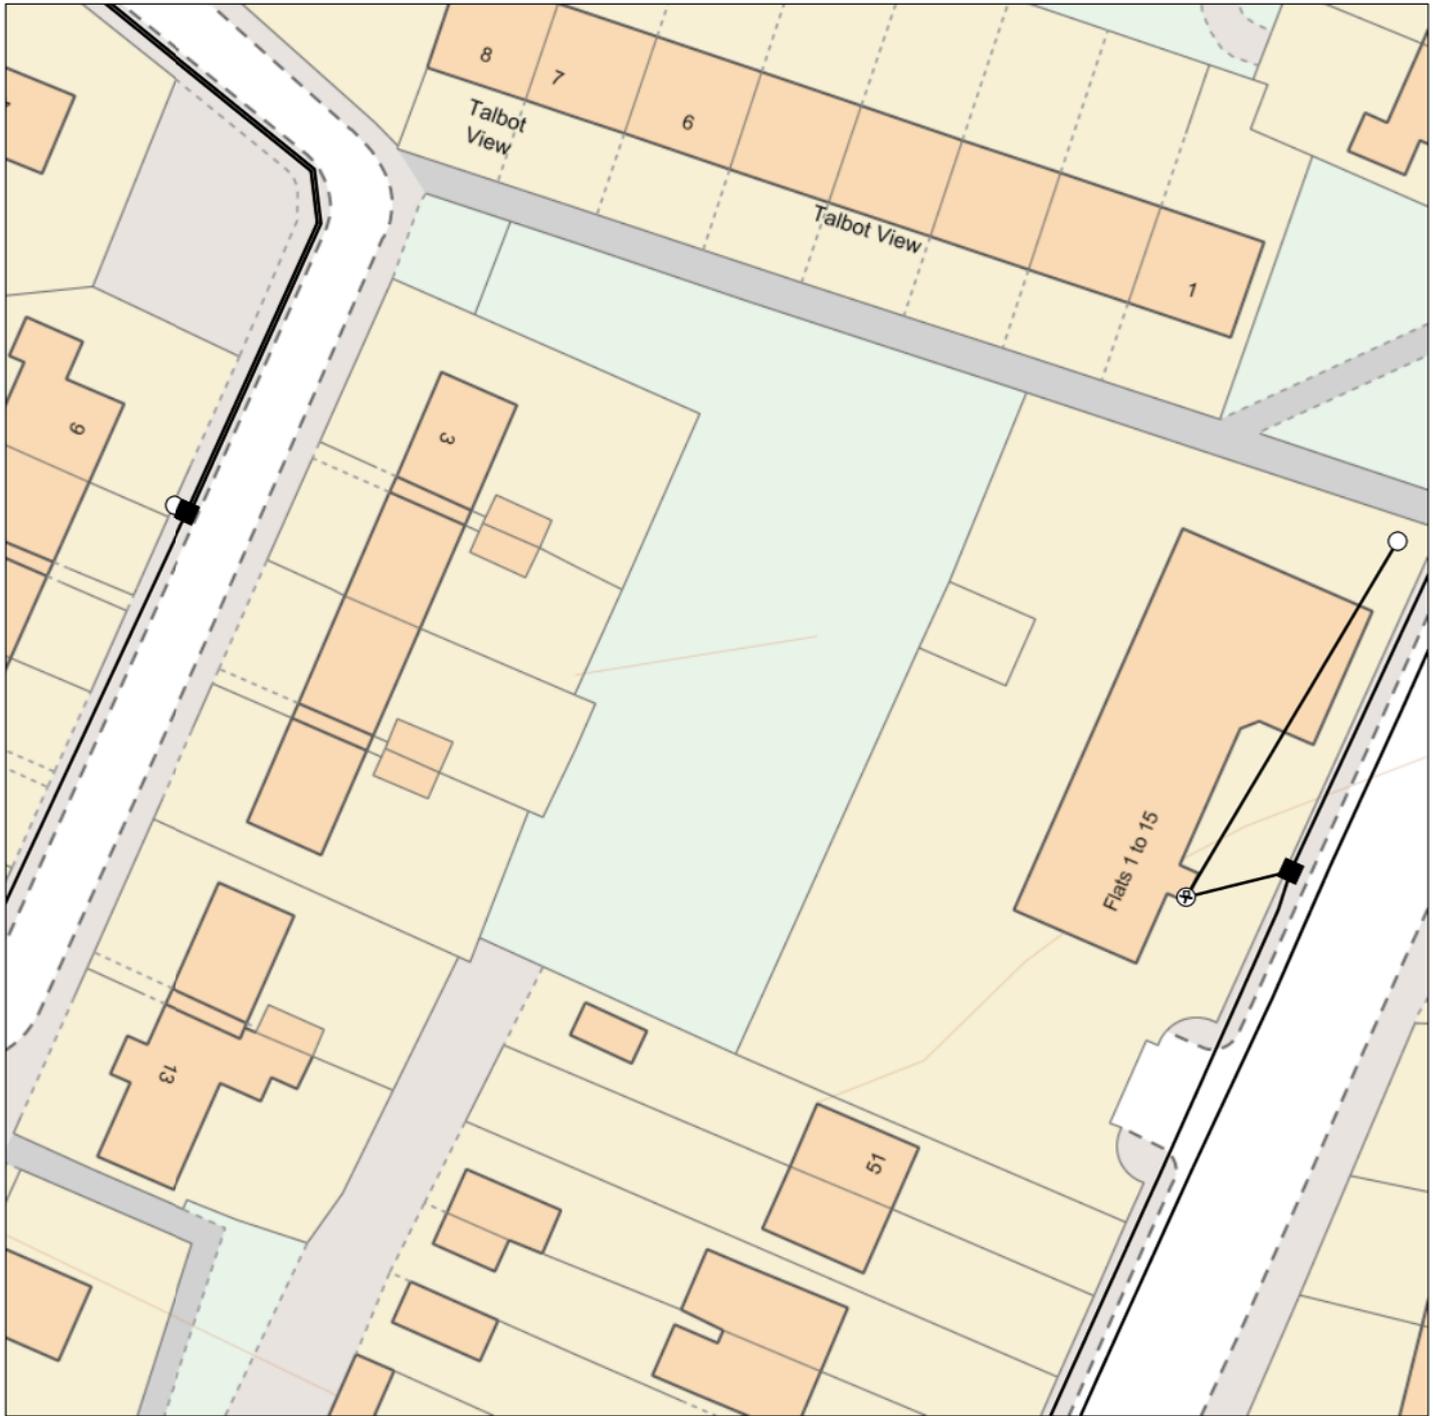

IMPORTANT WARNING

Information regarding the location of BT apparatus is given for your assistance and is intended for general guidance only. No guarantee is given of its accuracy.

It should not be relied upon in the event of excavations or other works being made near to BT apparatus which may exist at various depths and may deviate from the marked route.



openreach

CLICK BEFORE YOU DIG

FOR PROFESSIONAL FREE ON SITE ASSISTANCE PRIOR TO COMMENCEMENT OF EXCAVATION WORKS INCLUDING LOCATE AND MARKING SERVICE

email cbyd@openreach.co.uk

ADVANCE NOTICE REQUIRED
(Office hours: Monday - Friday 08.00 to 17.00)
www.openreach.co.uk/cbyd

Reproduced from the Ordnance Survey map by BT by permission of Ordnance Survey on behalf of the Controller of Her Majesty's Stationary Office
(C) Crown Copyright British Telecommunications plc 100028040

KEY TO BT SYMBOLS

| | | | | | |
|-------------|--------------------|-----------------|---|-------------------|--|
| | | Change Of State | + | Hatchings | |
| | <i>Planned</i> | <i>Live</i> | × | Built | |
| PCP | | | ▲ | Planned | |
| Pole | | | ■ | Inferred | |
| Box | | | Ⓚ | Duct | |
| Manhole | | | Other proposed plant is shown using dashed lines. BT Symbols not listed above may be disregarded. Existing BT Plant may not be recorded. Information valid at time of preparation. Maps are only valid for 90 days after the date of publication. | | |
| Cabinet | | | | | |
| | <i>Pending Add</i> | <i>In Place</i> | <i>Pending Remove</i> | <i>Not In Use</i> | |
| Power Cable | | | | | |
| Power Duct | | | | N/A | |

BT Ref : GXU09362P

Map Reference : (centre) SE2001020913

Easting/Northing : (centre) 420010,420913

Issued : 22/06/2019 09:36:43

WARNING: IF PLANNED WORKS FALL INSIDE HATCHED AREA IT IS ESSENTIAL BEFORE PROCEEDING THAT YOU CONTACT THE NATIONAL NOTICE HANDLING CENTRE. PLEASE SEND E-MAIL TO: nnhc@openreach.co.uk

Electric:

Job Reference : SD25378

8977 - Fox Royd Drive

Scale : 1:500

Grid Coordinates : 420011 420919

Date : 08/07/2019



Produced For :
Mr Carl Williams

Page 1 of 1


Terms and Conditions

Electric cables and/or overhead line information shown on the record plans are to be used in accordance with the Health & Safety Executive's Booklet HS(G)47, "Avoiding Danger from Underground Services" and Guidance Note GS 6, "Avoidance of Danger from Overhead Electric Lines". Record plans do not always show out of commission cables or service cables from Northern Powergrid's mains to adjoining or cross road properties. Plans do not show local authority owned public lighting or sign cables. The information is provided as a service by NorthernPowergrid and does not impart any legal obligation on their part. Persons using it are reminded of their responsibility to execute works safely to avoid damaging Northern Powergrid's apparatus.

Further advice or assistance is available from the Records Information Centre on 0191 2294296
In an emergency or outside normal working hours contact our customer information centre on 0800 668877
Cable depths shown were correct at the time cables were laid however alterations to ground levels or cable disposition may have taken place.

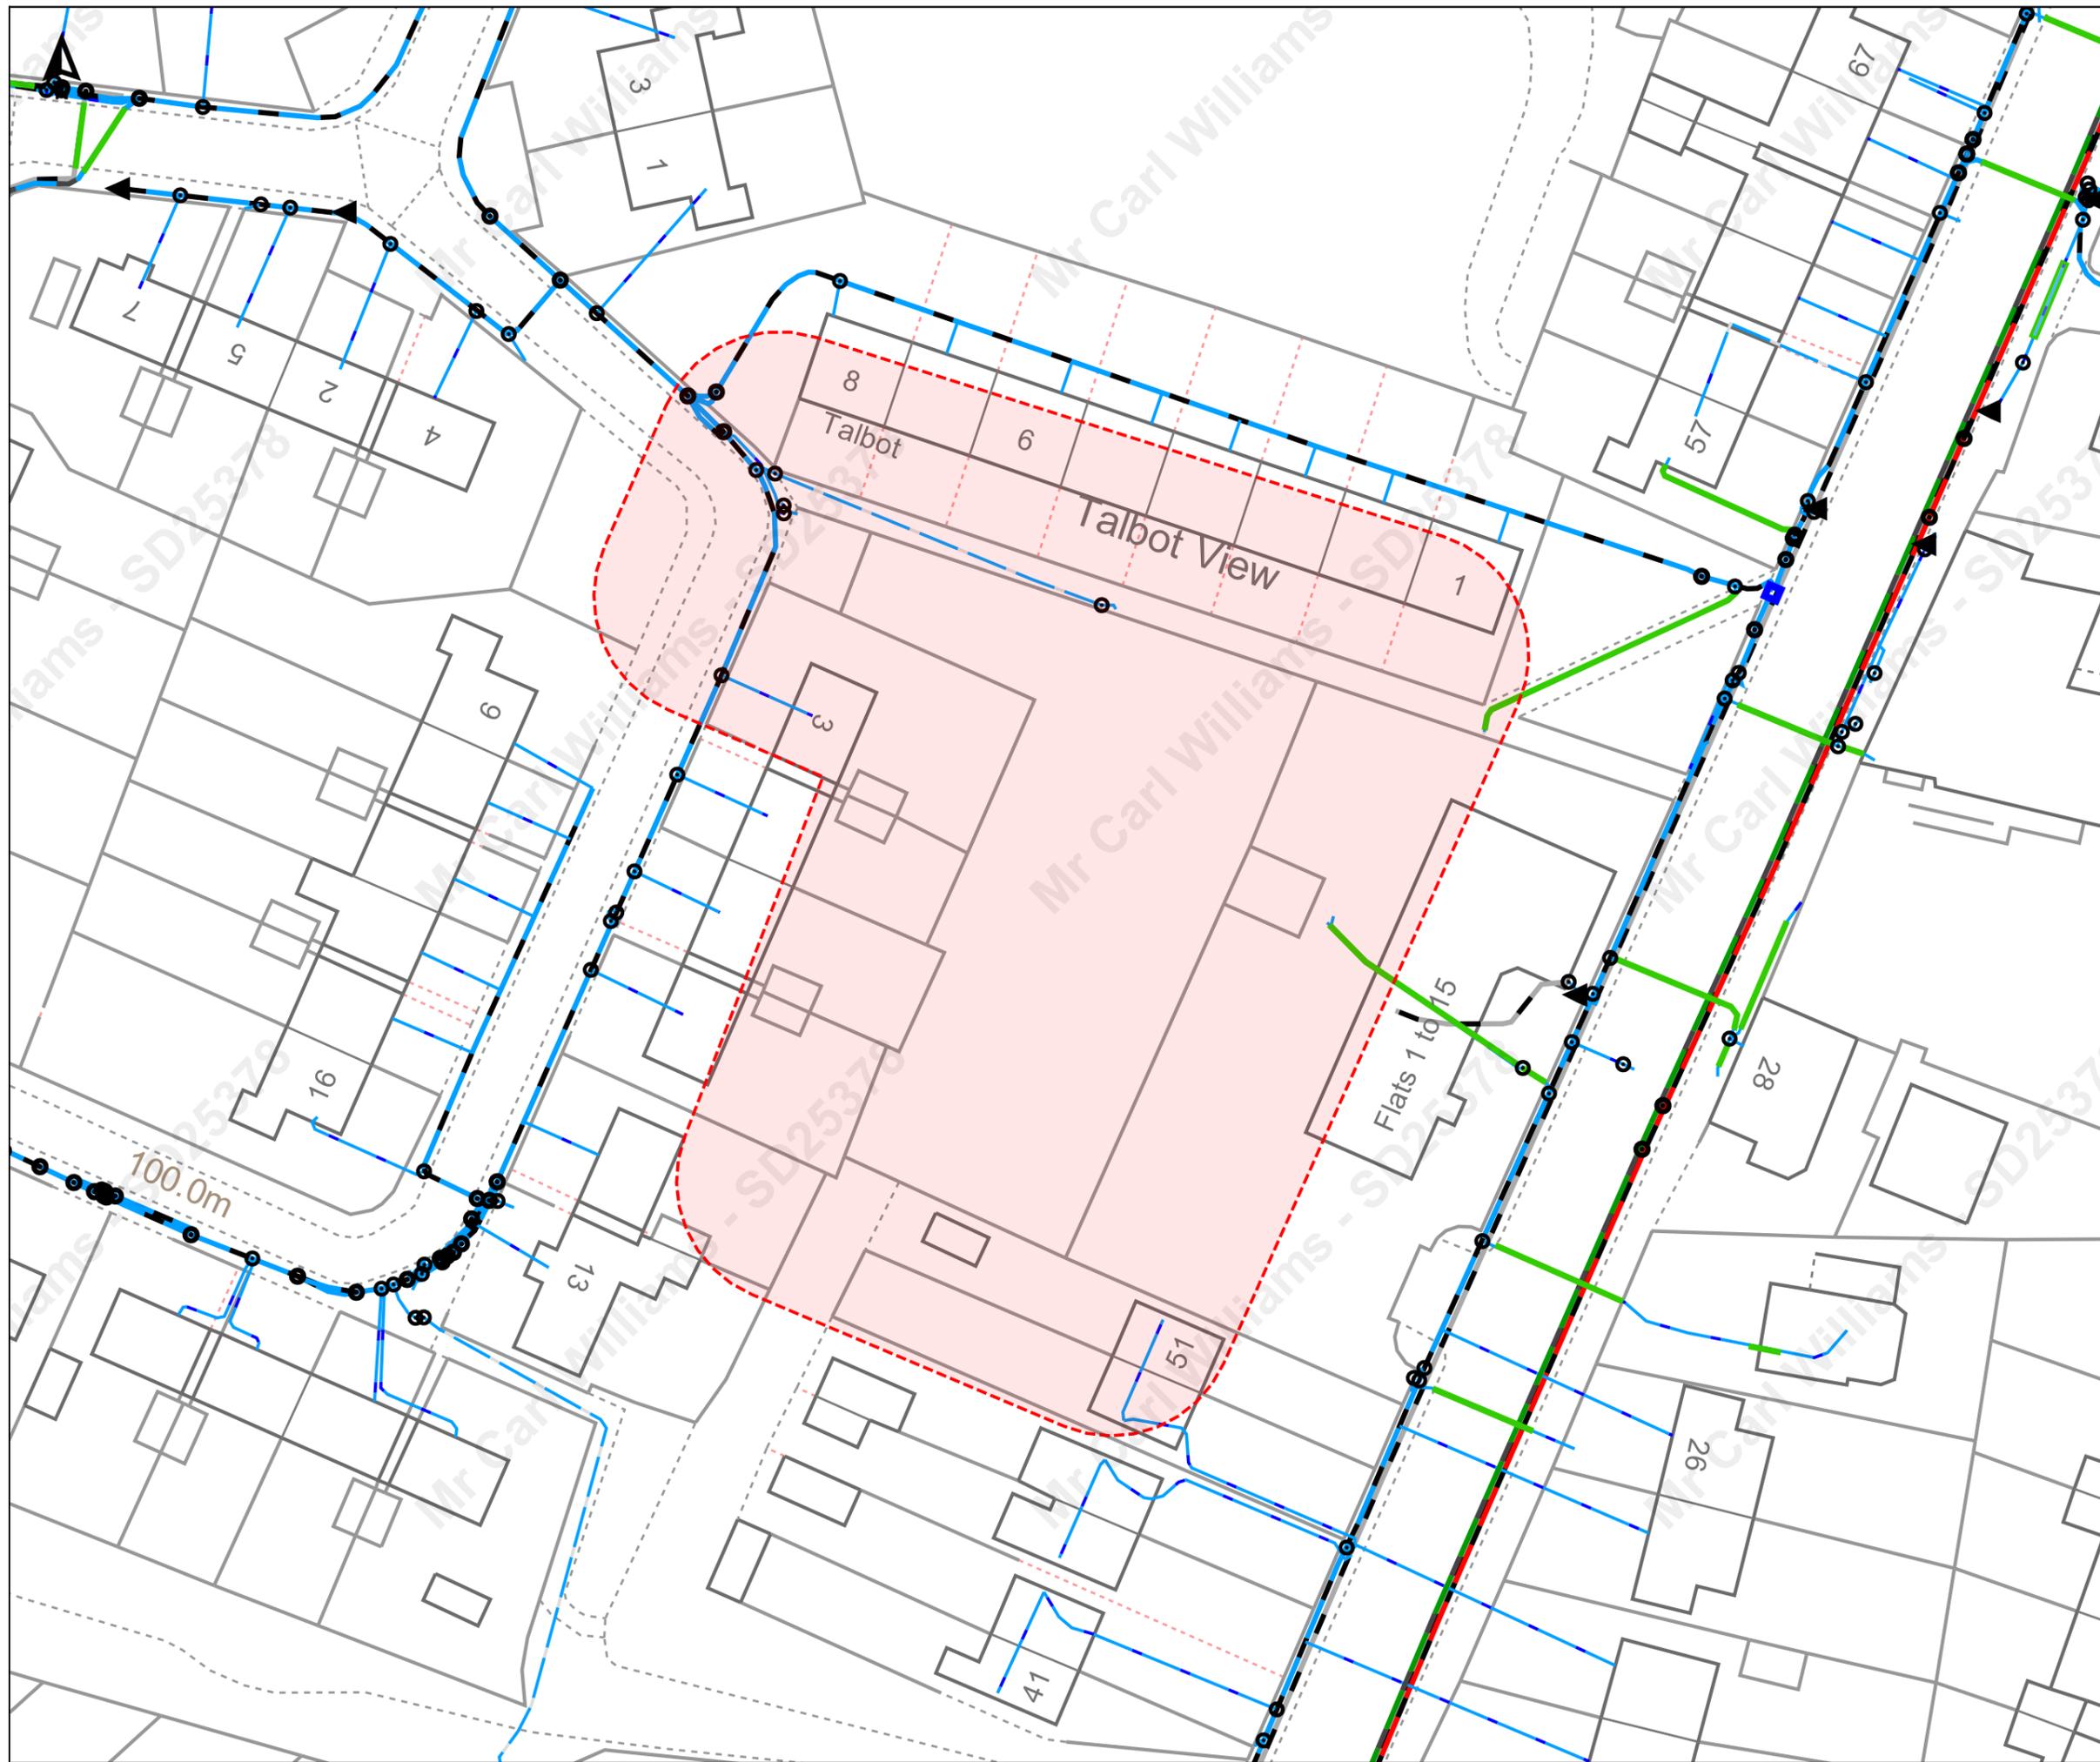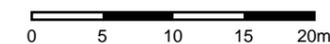


Gas:

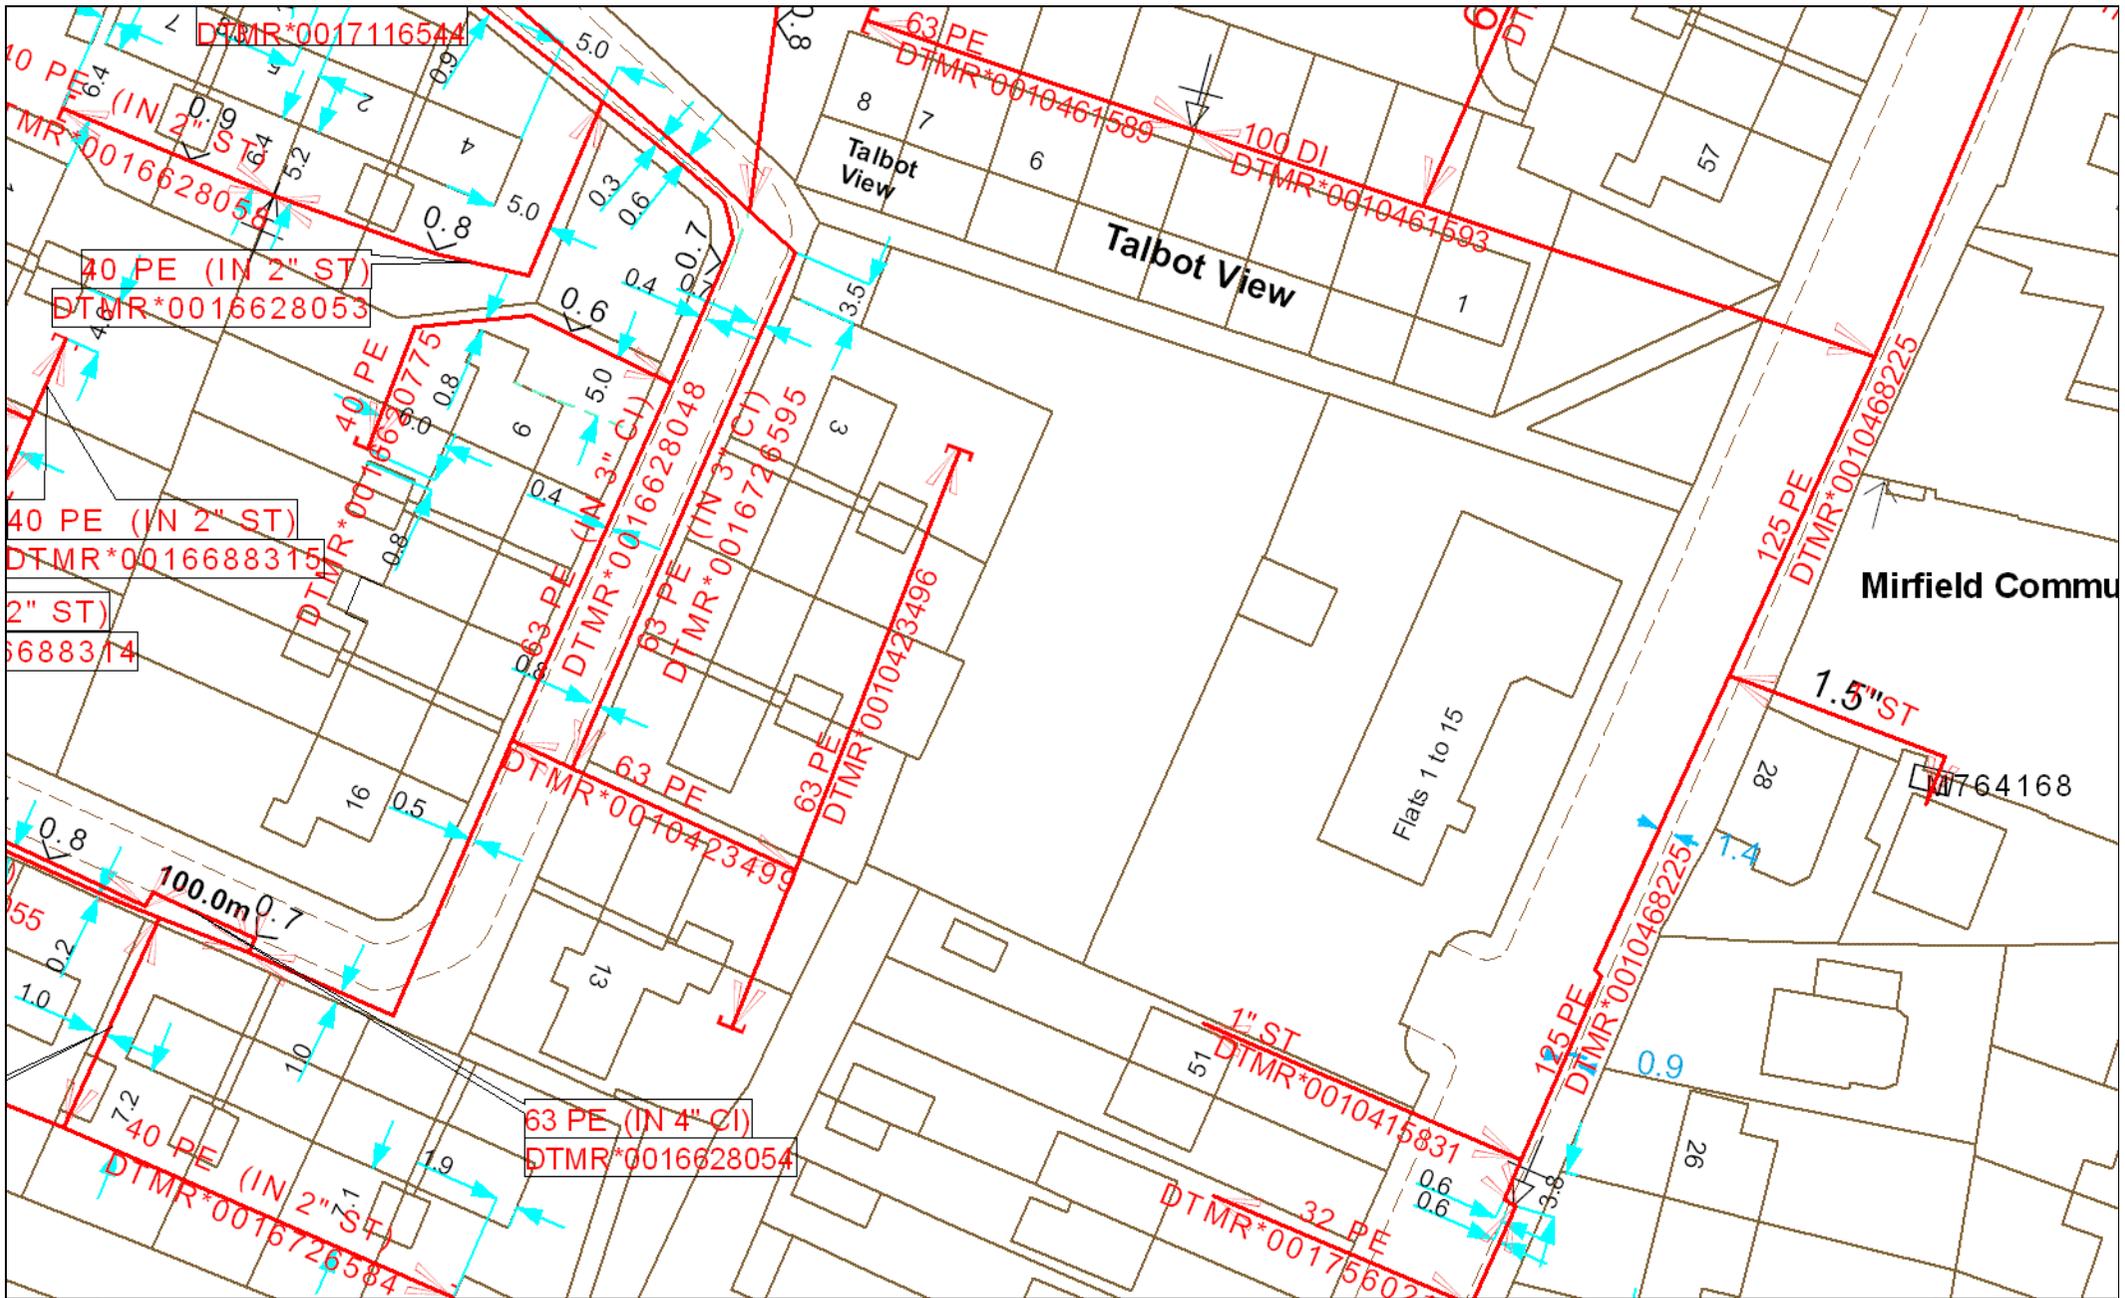

| | |
|--------------------------|---------------|
| Title: | |
| Scale: | 1:625 |
| User ID: | |
| Date: | 29/06/2019 |
| Grid Ref: | 420010,420914 |
| Internal Use Only | |


| | |
|--|--|
| <ul style="list-style-type: none"> — Low Pressure — Medium Pressure — Intermediate Pressure — Regional High Pressure | <ul style="list-style-type: none"> — Abandoned Pipe 1 — Abandoned Pipe 2 |
| Some examples of Plant Items: | |
| Valve | Depth of Cover |
| Syphon | Diameter Change |
| | Material Change |

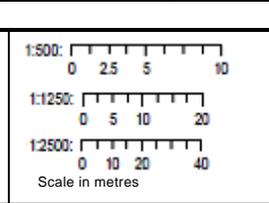

This plan shows those pipes owned by Northern Gas Networks or the relevant Gas Distribution Network in their roles as Licensed Gas Transporters (GT). Gas pipes owned by other GTs, or otherwise privately owned, may be present in this area. Information with regard to such pipes should be obtained from the relevant owners. The information shown on this plan is given without warranty, the accuracy thereof cannot be guaranteed. Service pipes, valves, syphons, stub connections, etc. are not shown but their presence should be anticipated. No liability of any kind whatsoever is accepted by Northern Gas Networks, the relevant Gas Distribution Network, or their agents, servants or contractors for any error or omission. Safe digging practices, in accordance with HSG47, must be used to verify and establish the actual position of mains, pipes, services and other apparatus on site before any mechanical plant is used. It is your responsibility to ensure that this information is provided to all persons (either direct labour or contractors) working for you on or near gas apparatus. The information included on this plan should not be referred to beyond a period of 28 days from the date of issue.


This plan is reproduced or based on the OS map by Northern Gas Networks, with the sanction of the controller of HM Stationary Office. Crown Copyright Reserved.

Water:

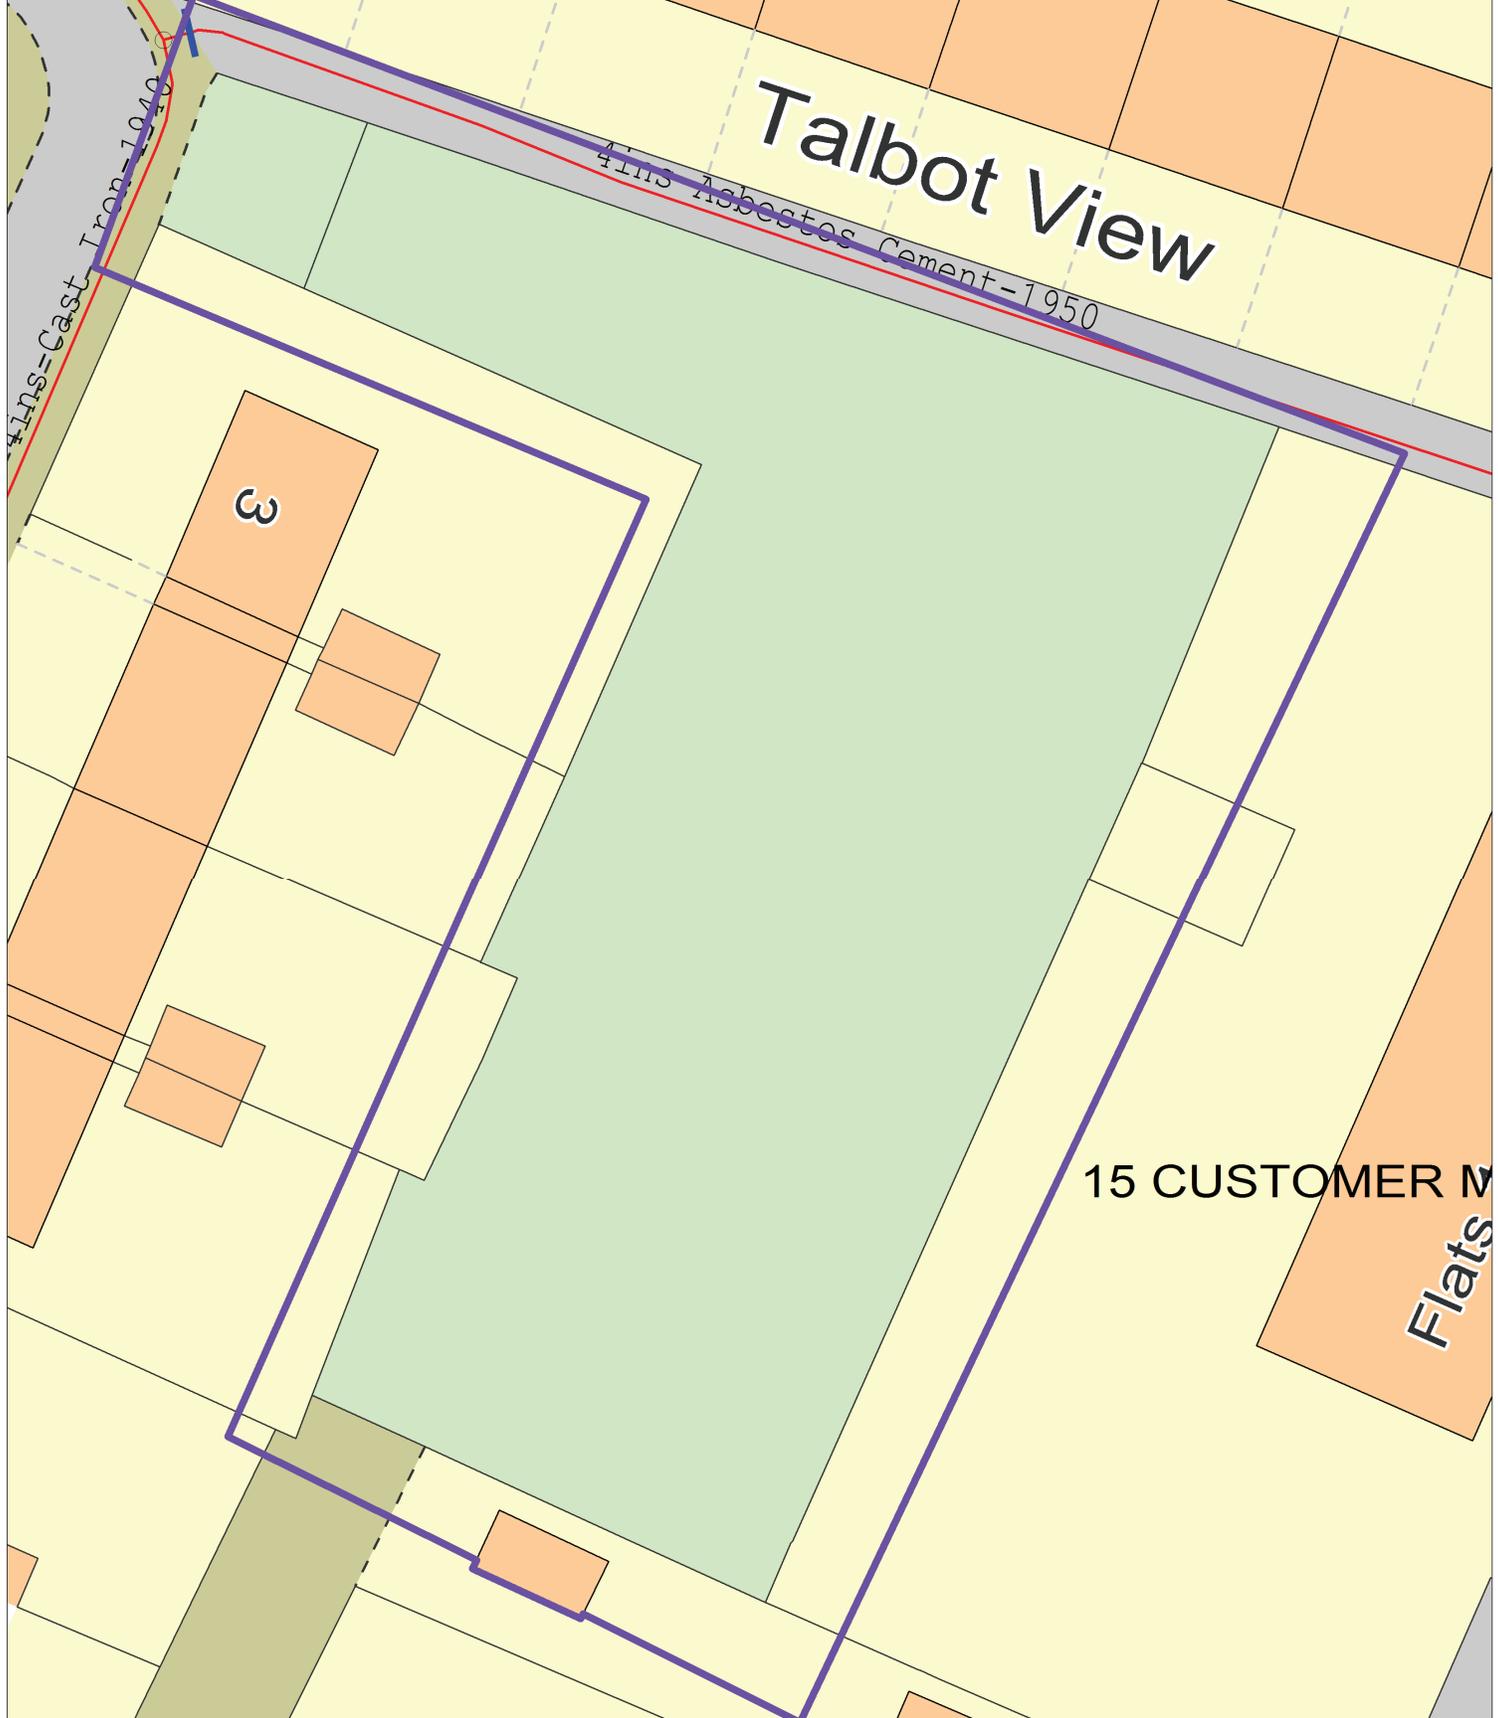


Public Clean Water Network 24/06/2019 07:41:18 OS Grid Coordinates: 419981 : 420883 Map Name : SE1920NE svcGISSafeMo

Wastewater:

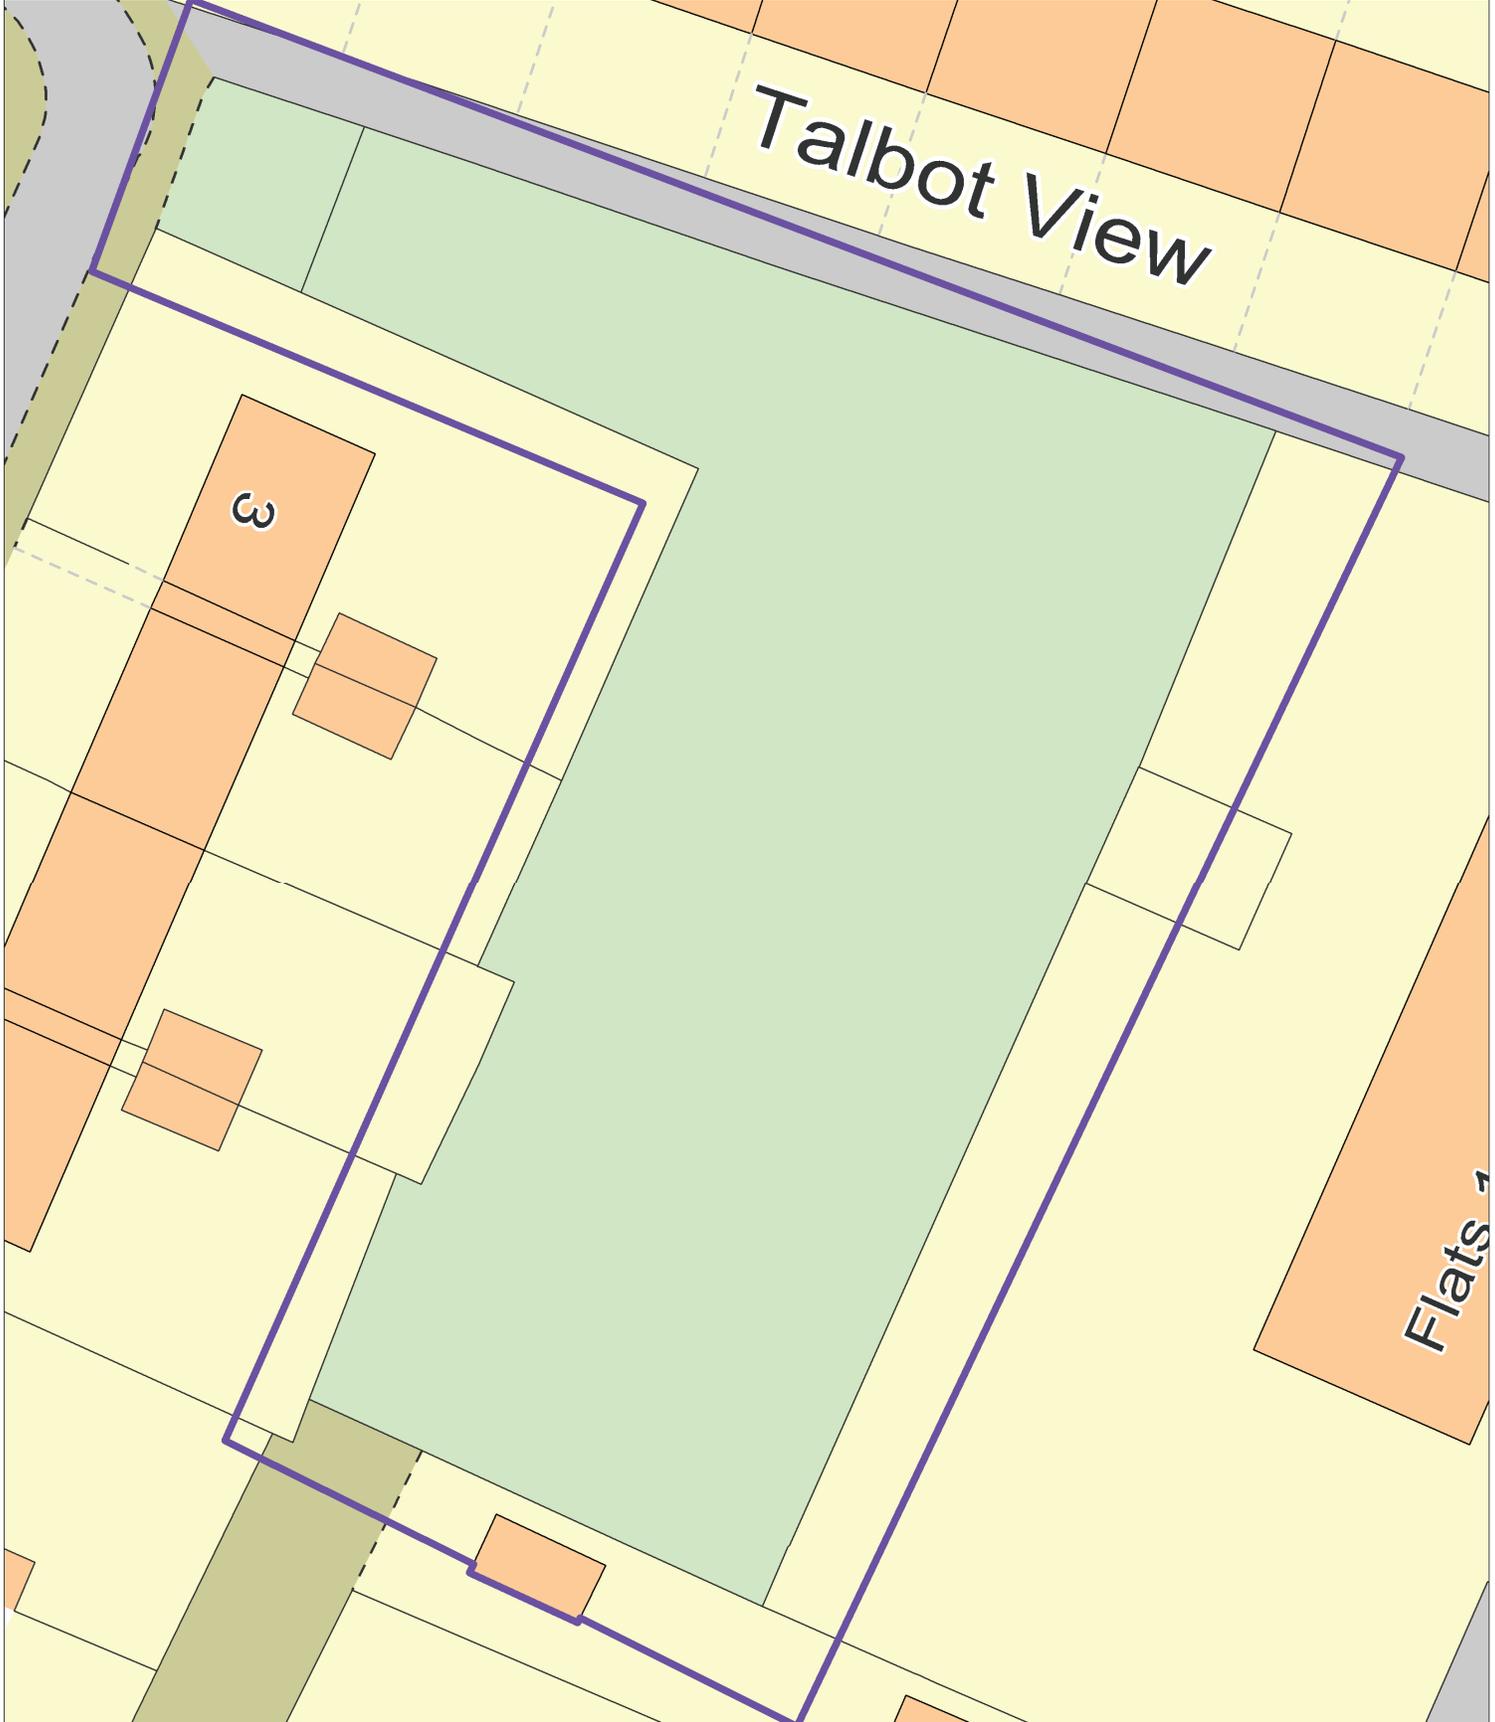

Public Waste Water Network 24/06/2019 07:41:21 OS Grid Coordinates: 419981 : 420883 Map Name : SE1920NE svcGISSafeMo

Cable & others:

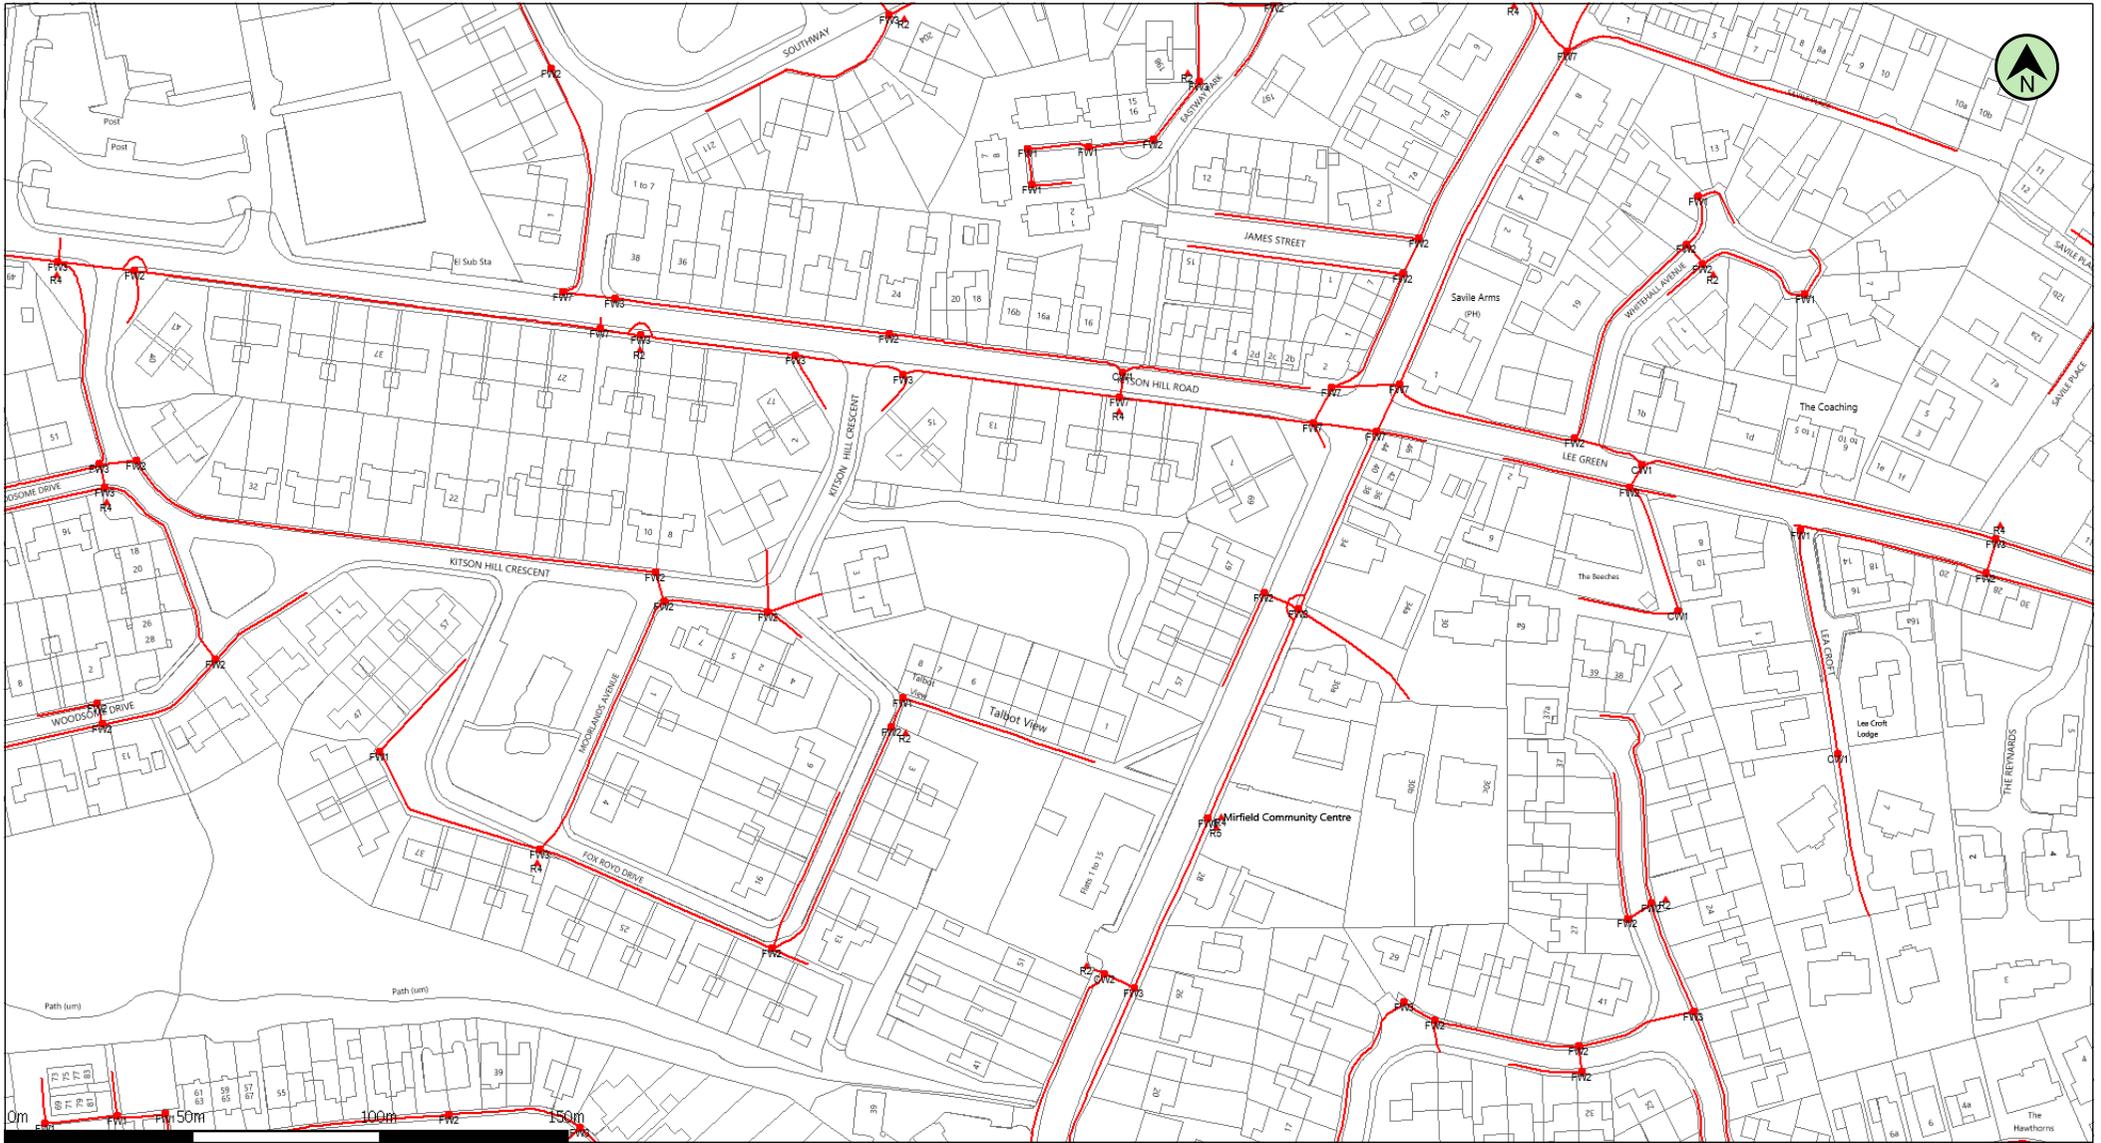

(c) Crown copyright and database rights 2019 Ordnance Survey 100019209

Date: 24/06/19

Scale: 1:2011

Map Centre: 420028,420984

Data updated: 01/05/19

Telecoms Plan A4

Important Information - please read The purpose of this plan is to identify Virgin Media apparatus. We have tried to make it as accurate as possible but we cannot warrant its accuracy. In addition, we caution that within Virgin Media apparatus there may be instances where mains voltage power cables have been placed inside green, rather than black ducting. Further details can be found using the "Affected Postcodes.pdf", which can be downloaded from this website. Therefore, you must not rely solely on this plan if you are carrying out any excavation or other works in the vicinity of Virgin Media apparatus. The actual position of any underground service must be verified by cable detection equipment, etc. and established on site before any mechanical plant is used. Accordingly, unless it is due to the negligence of Virgin Media, its employees or agents, Virgin Media will not have any liability for any omissions or inaccuracies in the plan or for any loss or damage caused or arising from the use of and/or any reliance on this plan. This plan is produced by Virgin Media Limited (c) Crown copyright and database rights 2019 Ordnance Survey 100019209.

Duct, Trench



Chamber



Cabinet



stephy.jaison@virginmedia.co.uk

VM.1138850

