A1

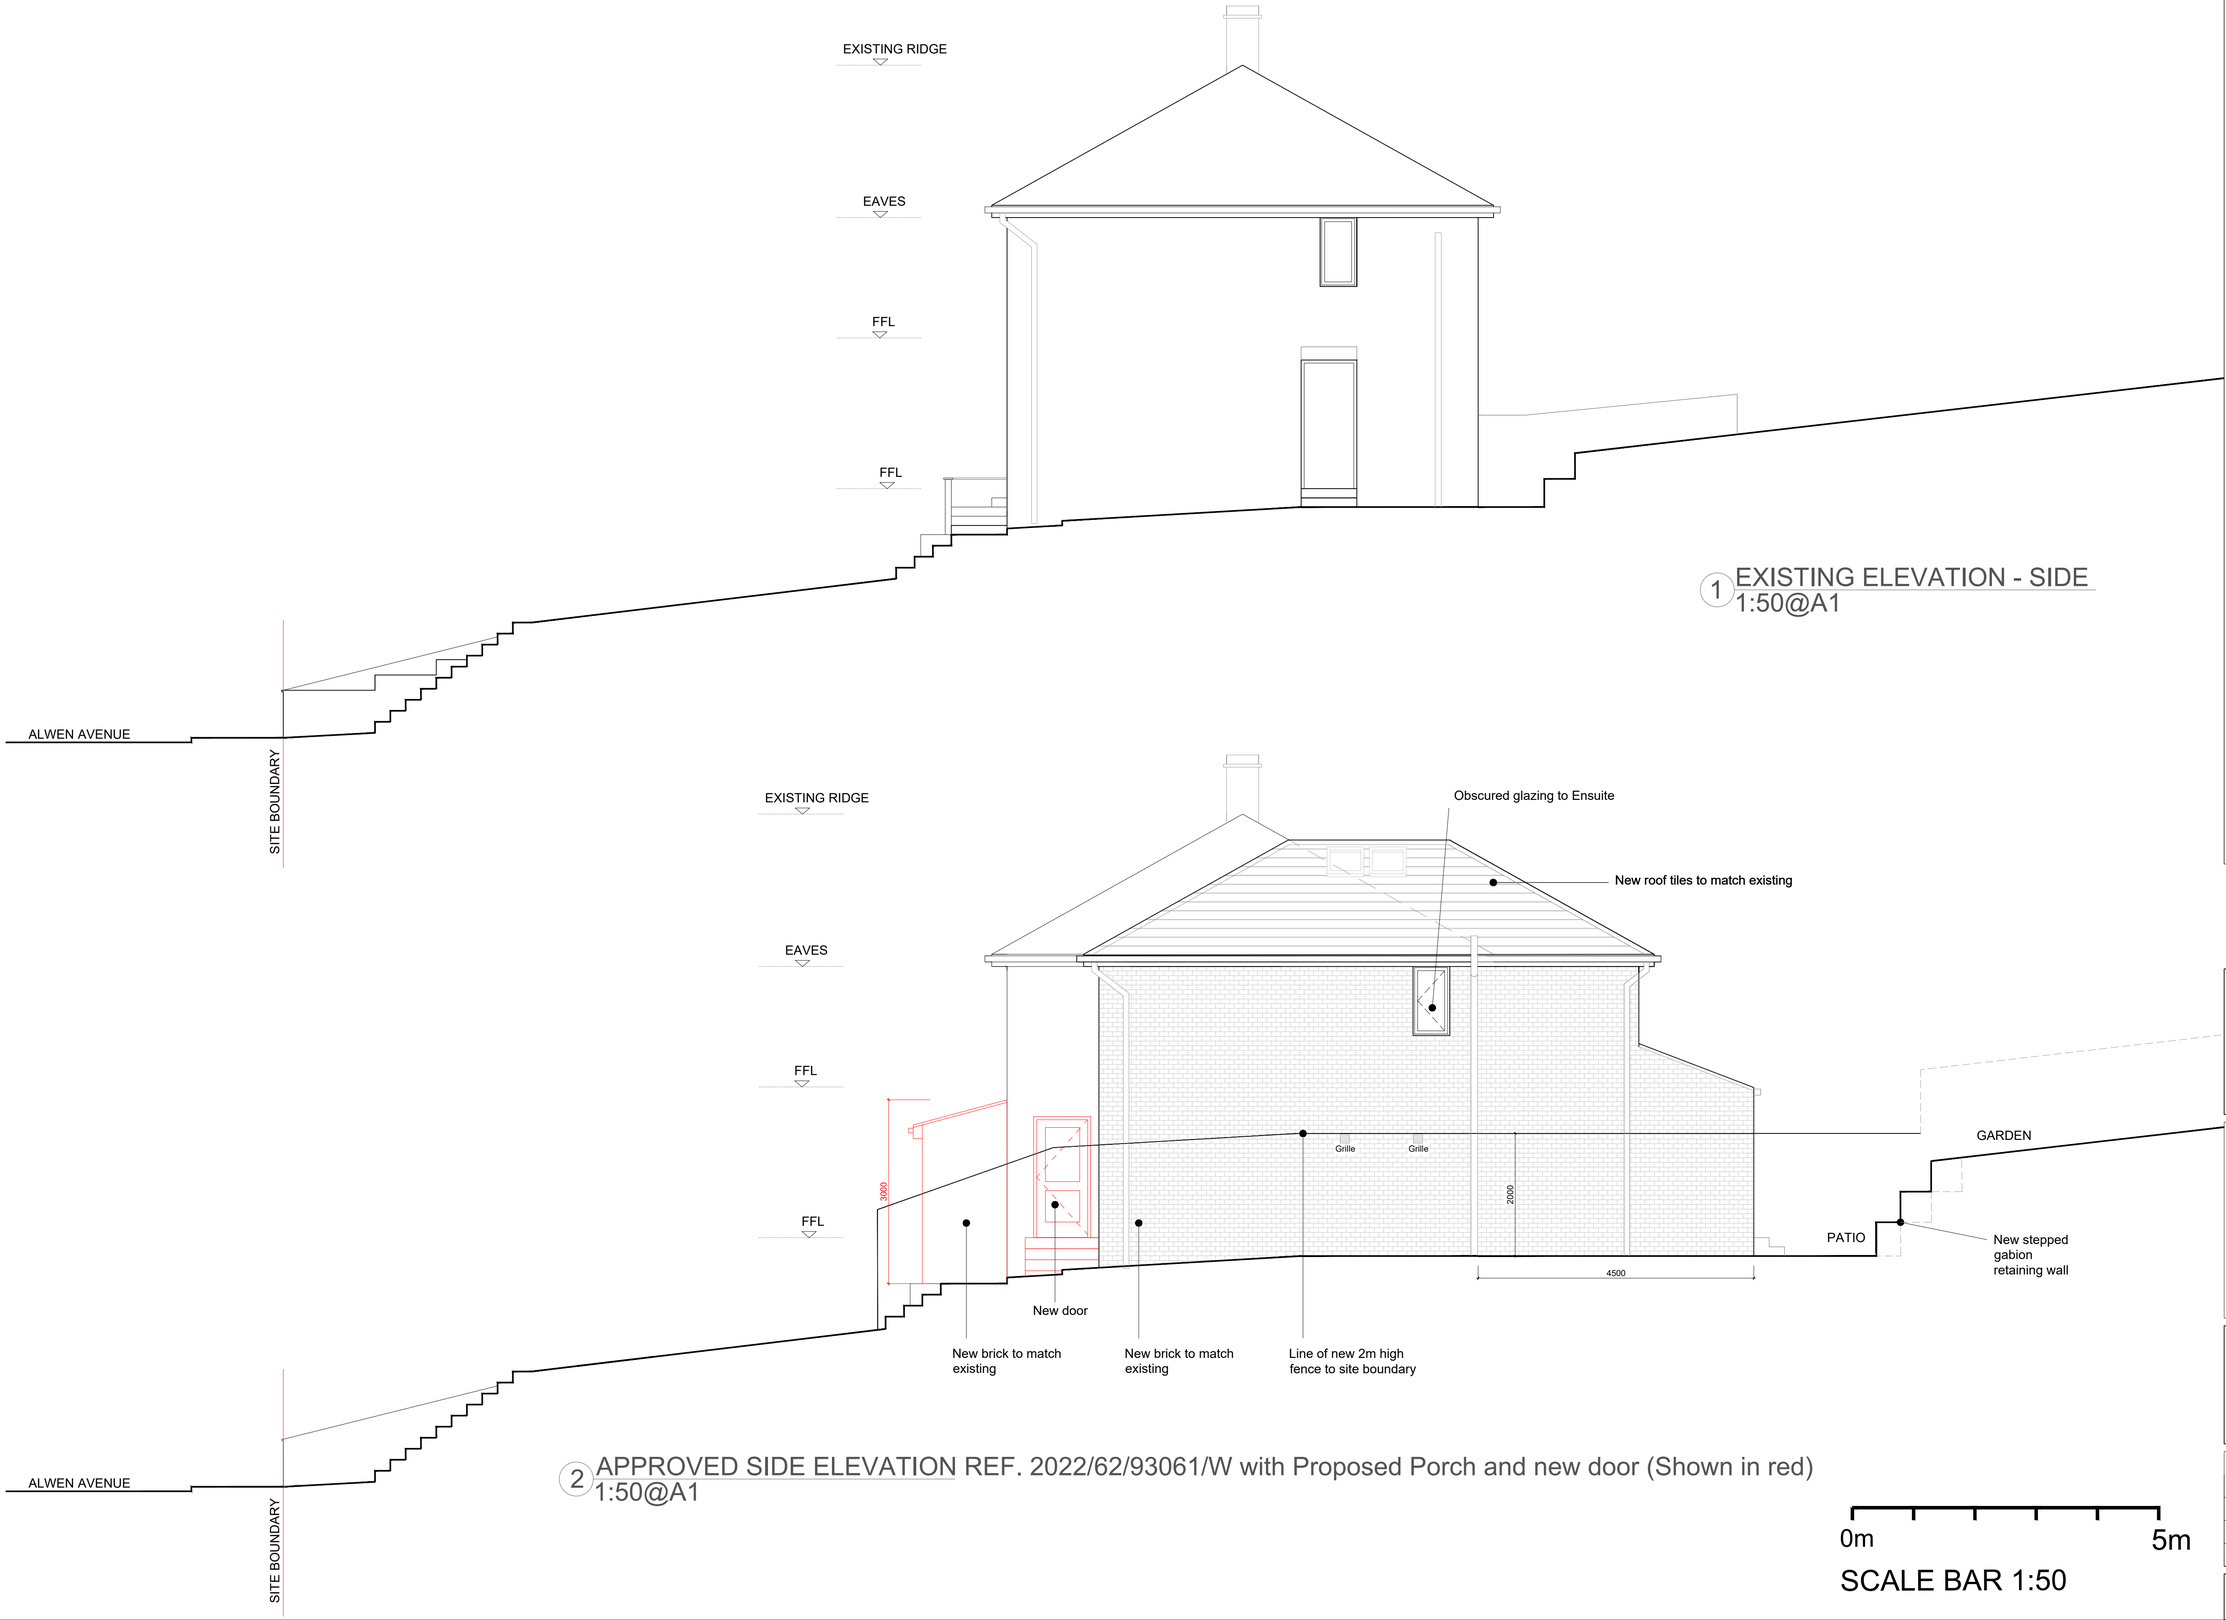

1 EXISTING ELEVATION - SIDE
1:50@A1

2 APPROVED SIDE ELEVATION REF. 2022/62/93061/W with Proposed Porch and new door (Shown in red)
1:50@A1

0m 5m

SCALE BAR 1:50

FIGURED DIMENSIONS ONLY TO BE USED

Notes

This drawing has been prepared for the purposes shown in the Status box only. All dimensions to be site checked by contractors on site prior to the commencement of works.

Revisions

Thomas Morgan Architect
1 New Hagg, Holmfirth
HD9 6RN
www.thomas-morgan.co.uk

34 Alwen Avenue
Birkby
Huddersfield
HD2 2SJ

Key Plan

Drawing Title

EXISTING & PROPOSED ELEVATIONS 2

Scale bar	
Scale	1:100@A3/1:50@A1
Status	PLANNING
First Issued	10/03/2023

Job No.	Dwg. No.	Rev.
2104	/ 104-3	A

PLOT ID: Thomas Morgan Architect