Do not scale from this drawing. Use figured dimensions only.

Contractors to verify all dimensions on site before commencing any work or shop drawings.

If drawings or specifications exceed the quantities taken in any way, Fibre Architects are to be informed before the work is initiated.

All drawn information is based on Ordnance Survey and/or existing record drawings. All content subject to Site Survey, Structural Survey, Site Investigations, Planning and other Statutory Approvals.

This drawing is not to be reproduced in whole or part without the consent of Fibre Architects Ltd.

Fibre Architects Limited Copyright.

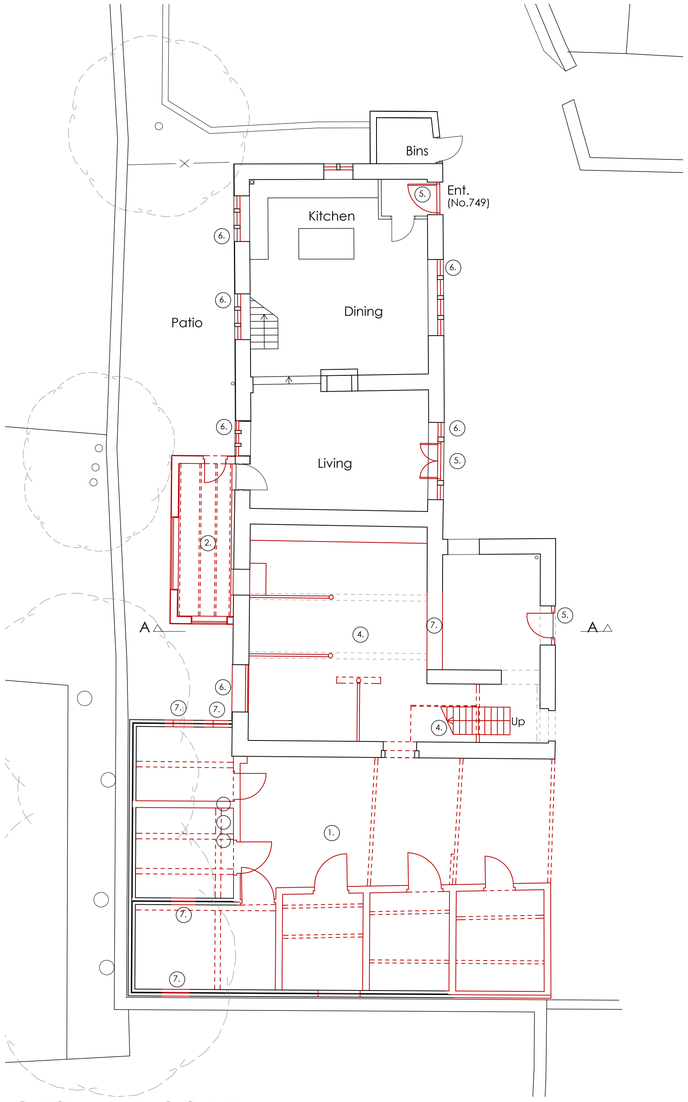

GROUND FLOOR PLAN

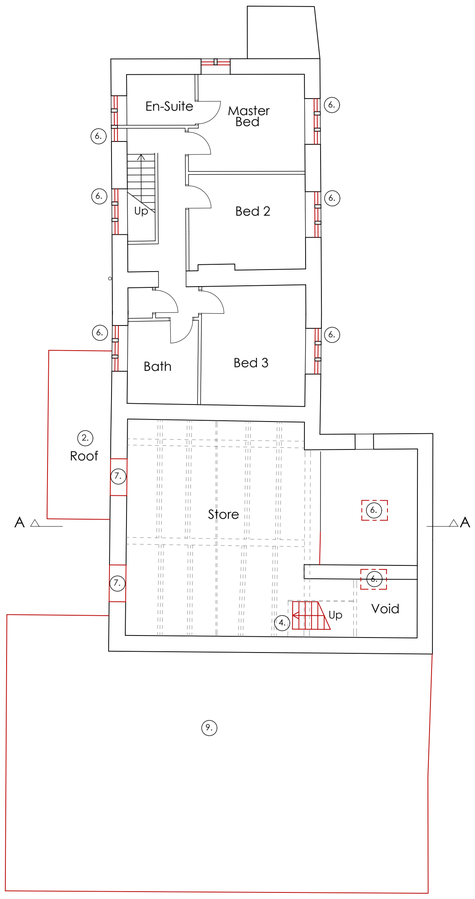

FIRST FLOOR PLAN

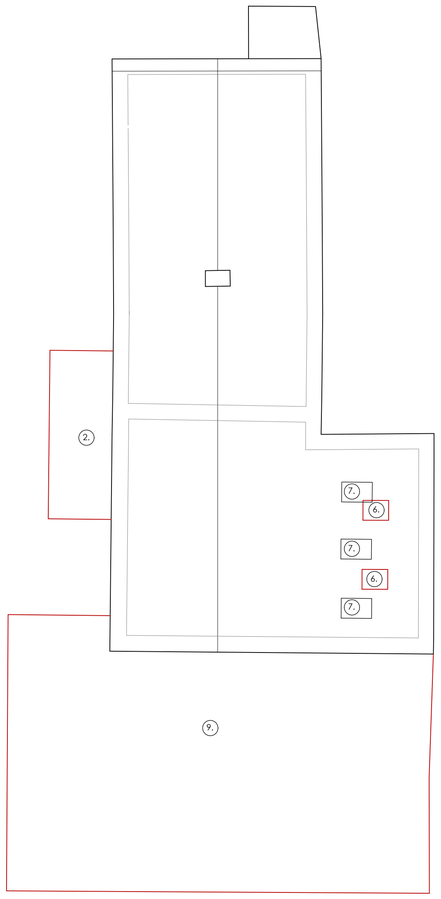

ROOF PLAN

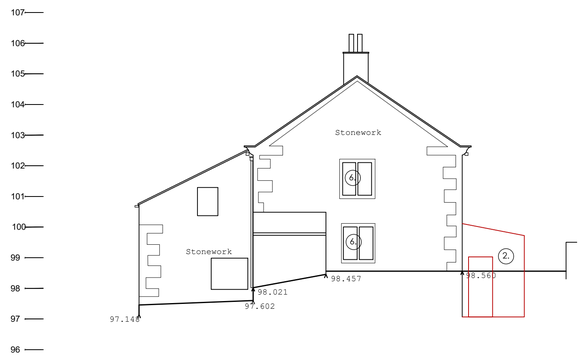

NORTH WEST ELEVATION

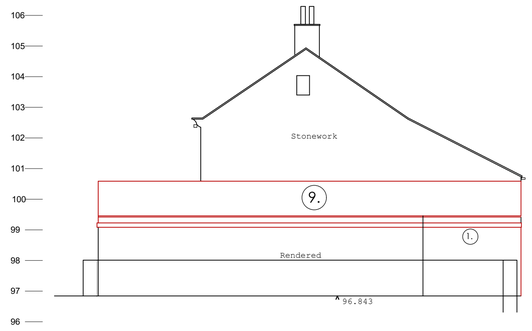

SOUTH EAST ELEVATION

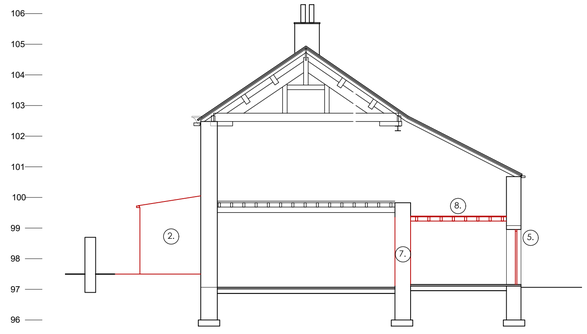

SECTION A-A

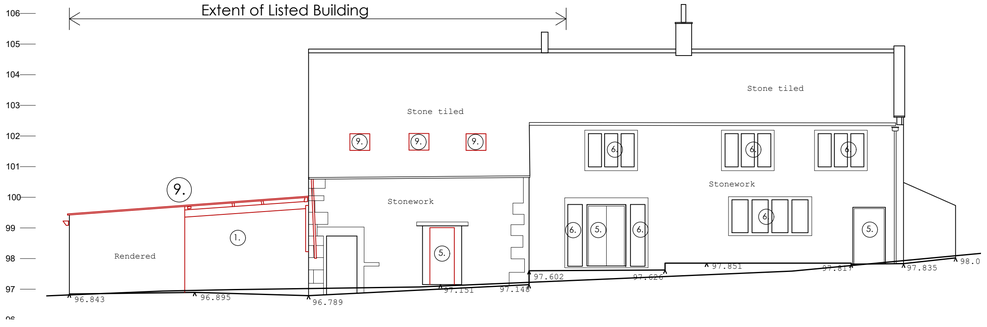

NORTH EAST ELEVATION

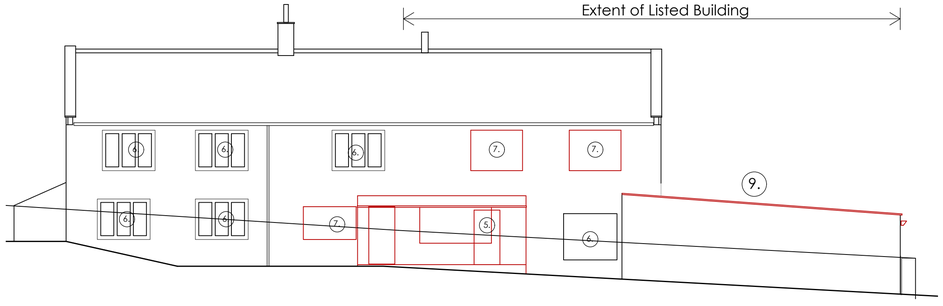

SOUTH WEST ELEVATION

NOTES

Please refer to drawing set plus heritage and design assessment for further details. Demolitions are noted in brown.

1. Remove Stables Non-original.
2. Remove Extension Non-original.
3. Roof Opening (Skylights)
4. Remove internal stable partition walls and staircase. Non-original.
5. Remove Door Non-original.
6. Remove Window Non-original.
7. Form Structural Opening
8. Remove floor Non-original.
9. Remove roof Non-original.

Scale 1:100 — 0 — 5m — 10m

HOUSE-TYPE A - CONVERTED BARN (LISTED BUILDING)

DEMOLITIONS

Rev	Description	Date	By	App'd
B	General Updates	20/03/23	DH	MO
A	General Updates	05/09/22	MO	-

Project Domestic Refurbishment 749 New Hey Road, Outlane, Huddersfield, HD3 3YL		Project no 21.009	Date 20/03/2023
Drawing Title Demolitions as Proposed -		Scale @ A1 As Shown	Drawn by DH / Appr. by MO
Client Dominic Waterson -		Drawing no AL0004	Rev B

Fibre Architects

First Floor Buckden Mount
8 Thornhill Road
Huddersfield, HD3 3AU

Tel: 01484 544 410
www.fibrearchitects.co.uk
Email: info@fibrearchitects.co.uk