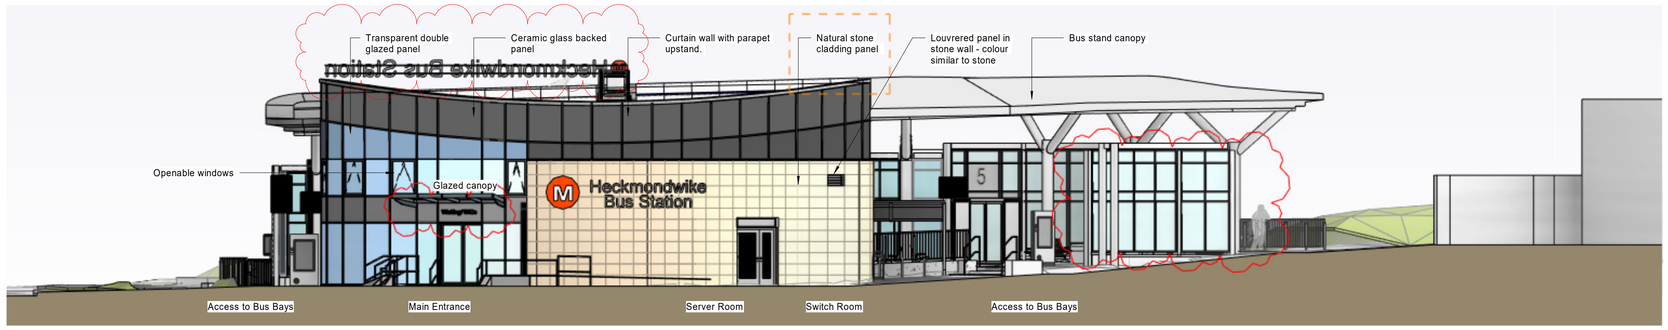

E1 South Elevation
1 : 100

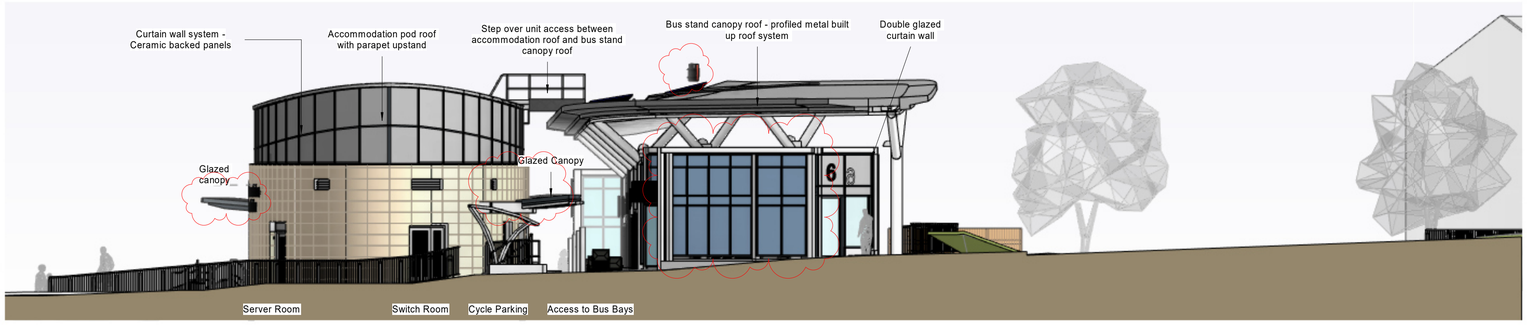

E2 East Elevation
1 : 100

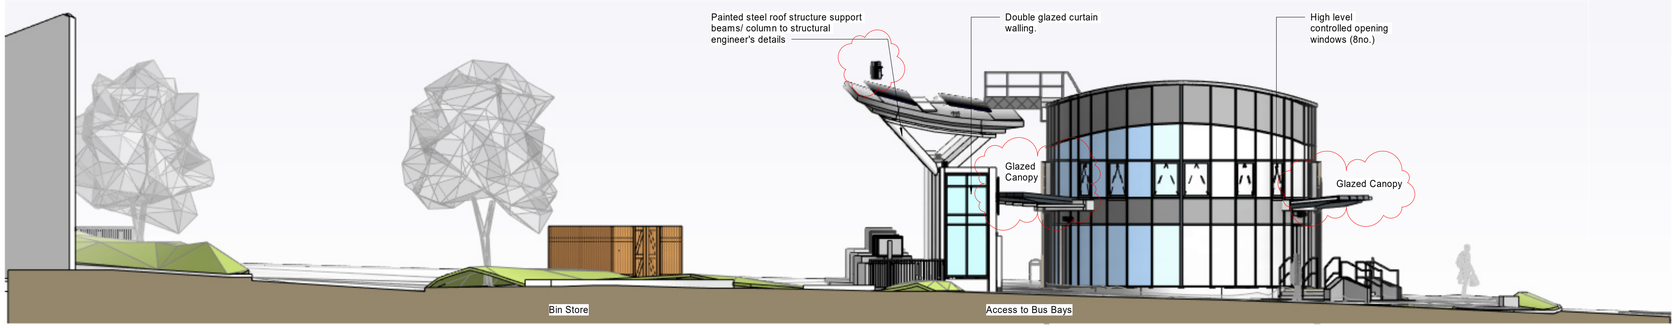

E3 West Elevation
1 : 100

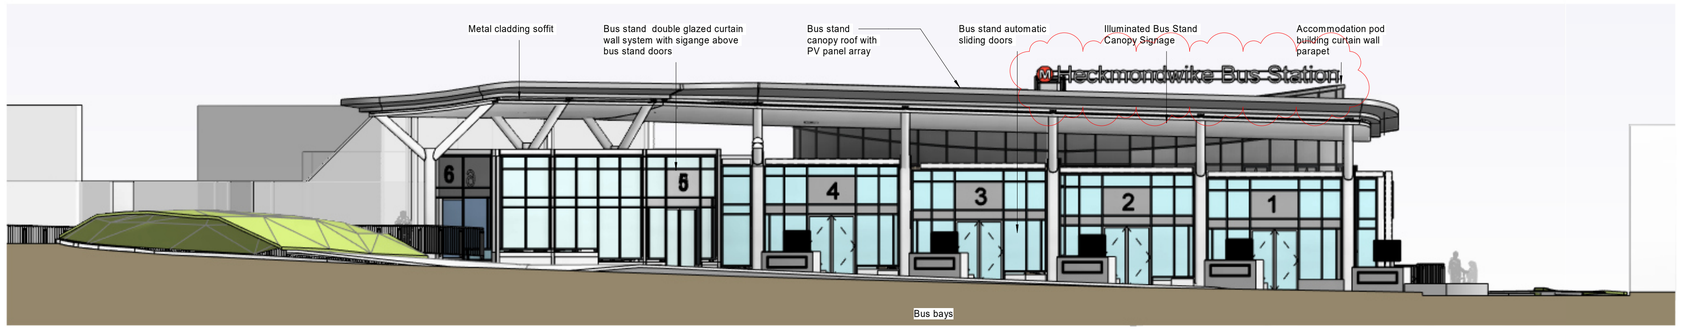

E4 North Elevation
1 : 100

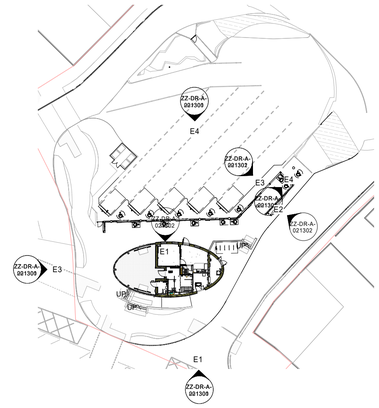

KP Key Plan
1 : 500

Rev	Date	By	Description
P1	25/06/21	DM	Drawing/ job number revised. Changes to Pod waiting area include development of glass canopy to pod, Retail area removed and Driver's mess, office and server room added. Bus Stand Canopy simplified.
P2	22/07/21	DM	Cladding material to Pod building shown as stone cladding. Window opening notes added to elevations and roof plan.
P3	21/02/2022	DM	Pod curtain walling increased to provide 1100 high parapet upstand. Floor deck and access stairs added to pod and step over ladder added to pod roof to provide access to bus stand canopy. Changes made in development of the roof access strategy.
P4	17/03/2022	DM	Issued for RIBA Stage 3
P5	30/03/2022	DM	Changes to plan include omission of south west ramp, step in FFLs and omission of Arriva office door in line with revised proposed levels dwg.
P6	08/07/2022	DM	Bus stand roof eaves profile amended. Colour of CW frames amended. Soffit finish amended.
P7	27/01/2023	DM	Issued for information to design team
P8	08/06/2023	SD	Issued for information
P9	16/06/2023	SD	Issued for Stage 4A
P10	Date 78	SE	Glass canopies to Pod amended.Bus Bay 6 entrance curtain wall amended.Signage amended .The naming of the elevations amended to show correct orientation.Submitted for a non material planning application

Existing surrounding building heights based on current Google Earth Pro information

SCALE 1:100
1m 5m 10m

Kirklees COUNCIL

SGP
Architects + Masterplanners

33 Park Place
Leeds
LS1 2RY

t: +44 (0)113 246 7969

www.stephengeorge.co.uk

Heckmondwike Bus Station
Royle Fold
Heckmondwike WF16 0HR

Drawing Name:
Elevations Sheet 1

Drawing Stage: **RIBA Stage 4A**

Status: **S4 - Suitable for stage approval**

SGP File Ref: 20233-SGP-HEK-ZZ-M3-A-200001

SGP Project No:	Date:	Drawn:	Team:	Scale:	Rev:
20-233-003	14/01/21	DM	Leeds	As indicated @ A1	P10

Drawing Number:
20233-003 SGP - HEK-ZZ-DR-A- 201300
Project Code Originator Volume Level Type Role Number

Red Line Boundary based on O/S Data and **NOT** confirmed as the Legal Boundary

This drawing, the works and concepts depicted are copyright of Stephen George + Partners LLP and may not be reproduced or made use of, either directly or indirectly without express written consent. All heights, levels, sizes and dimentions to be checked on site before any work is put to hand.