Rev	Date	By	Description
P1	17/03/2022	DM	Issued for RIBA Stage 3
P2	30/03/2022	DM	Changes to plan include omission of south west ramp, step in FFLs and omission of Arriva office door in line with revised proposed levels dwg.
P3	08/07/2022	DM	Bus stand roof eaves profile amended. Colour of CW frames amended. Soffit finish amended.
P4	27/01/2023	DM	Issued for information to design team
P5	08/06/2023	SD	Issued for information
P6	16/06/2023	SD	Issued for Stage 4A.
P7	Date 78	SE	Glass canopies to Pod amended.Bus Bay 6 entrance curtain wall amended.Signage amended. The naming of the elevations amended to show correct orientation.Submitted for a non material planning application

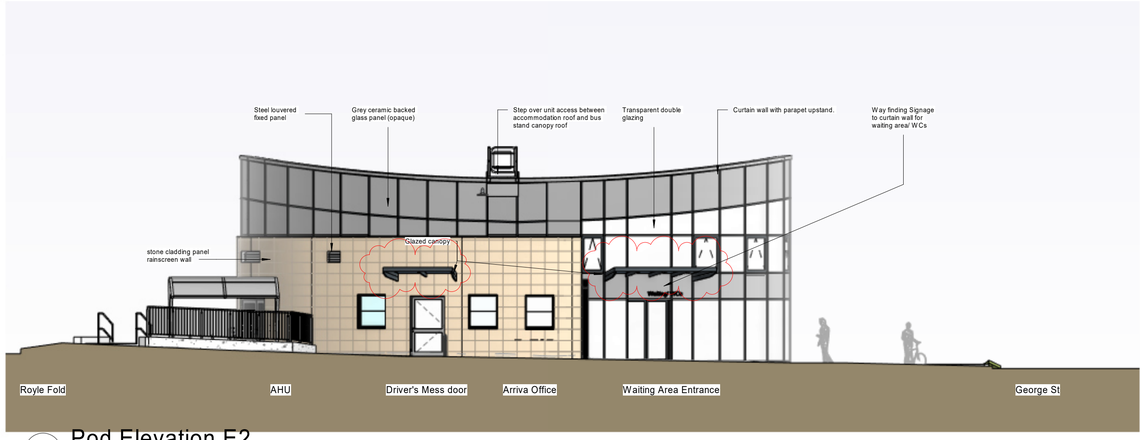

E5 Pod Elevation E2.
1 : 100

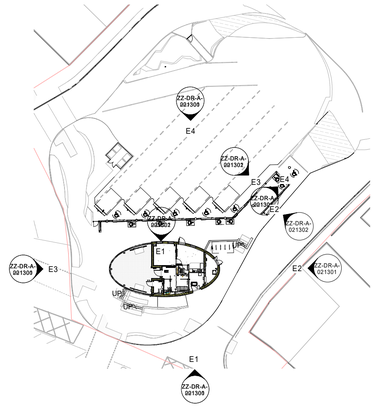

2 Key Plan 2
1 : 500

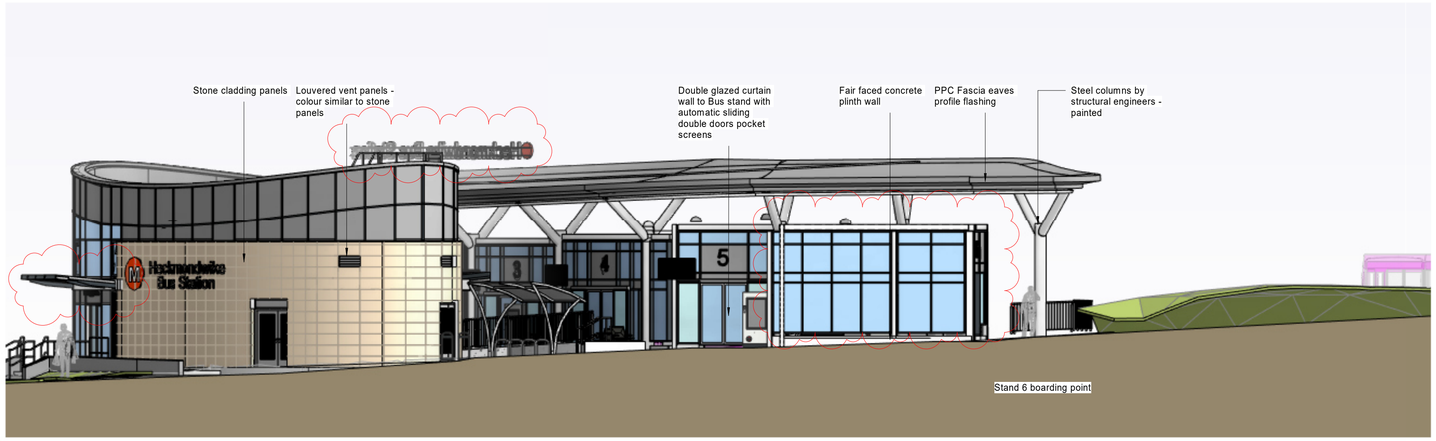

1 Pod Elevation E1.
1 : 100

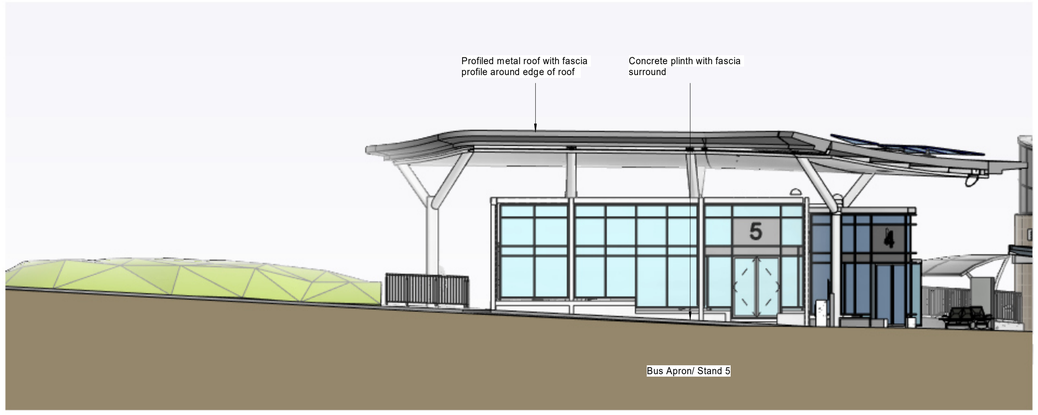

3 Elevation Bus Stand 5
1 : 100

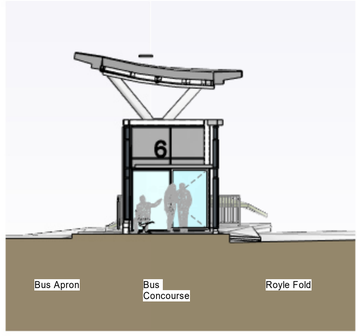

4 Elevation Bus Stand 6
1 : 100

Notes:

Refer to SGP dwg 400100 for floor finishes and floor build ups

Refer to SGP dwg 450100 for ceiling finishes

Refer to SGP dwg 511101 for Internal wall finishes

For colours and specifications of paint and tile finishes refer to SGP NBS specifcation and 20233-SGP-00-ZZ-SH-A-7502 Finishes Schedule

SCALE 1:100
1m 5m 10m

Kirklees COUNCIL

SGP
Architects + Masterplanners

33 Park Place
Leeds
LS1 2RY

t: +44 (0)113 246 7969

www.stephengeorge.co.uk

Heckmondwike Bus Station
Royle Fold
Heckmondwike WF16 0HR

Drawing Name:
Elevations Sheet 2

Drawing Stage: **RIBA Stage 4A**

Status: **S4 - Suitable for stage approval**

SGP File Ref: 20233-SGP-HEK-ZZ-M3-A-200001

SGP Project No:	Date:	Drawn:	Team:	Scale:	Rev:
20-233-003	02/25/22	DM	Leeds	As indicated @ A1	P7

Drawing Number:
20233-003 SGP - HEK-ZZ-DR-A- 201301
Project Code Originator Volume Level Type Role Number

Red Line Boundary based on O/S Data and **NOT** confirmed as the Legal Boundary

This drawing, the works and concepts depicted are copyright of Stephen George + Partners LLP and may not be reproduced or made use of, either directly or indirectly without express written consent. All heights, levels, sizes and dimentions to be checked on site before any work is put to hand.