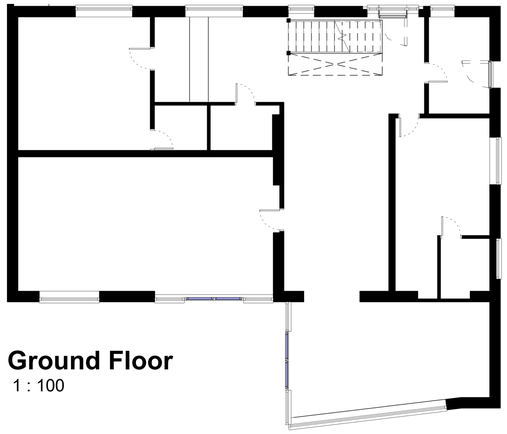

Ground Floor
1 : 100

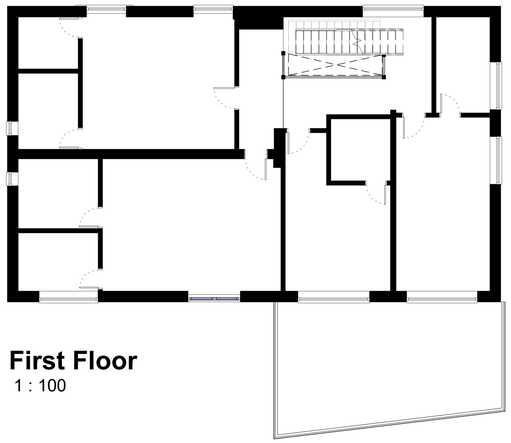

First Floor
1 : 100

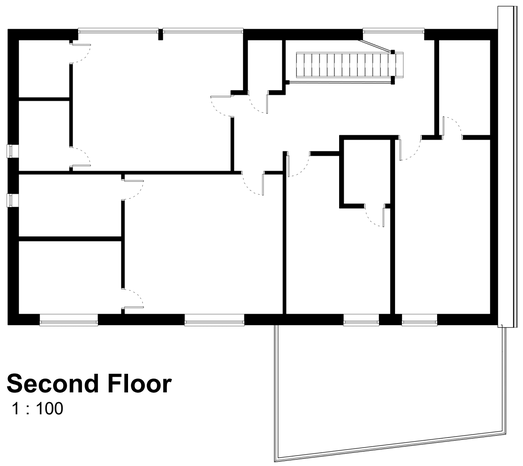

Second Floor
1 : 100

revision	date	drawn	description

N

Do not scale from drawings unless by agreement with designer. Use figured dimensions only. Check all dimensions on site prior to commencing the works. Drawing to be read in conjunction with other relevant consultant information.

This drawing is the copyright of HA Ltd and must not be copied or reproduced in part, or in whole, without the express permission of the architect. Drawing to be read in conjunction with specification.

Floor Plans
As-built

24-01-1-0200-Floor Plans
number
revision

Mr M Ashfaq
No.9 Inglewood Avenue, HD2 2DS

As indicated @ A1
scale

24-01
job reference

HA
drawn

AS-BUILT