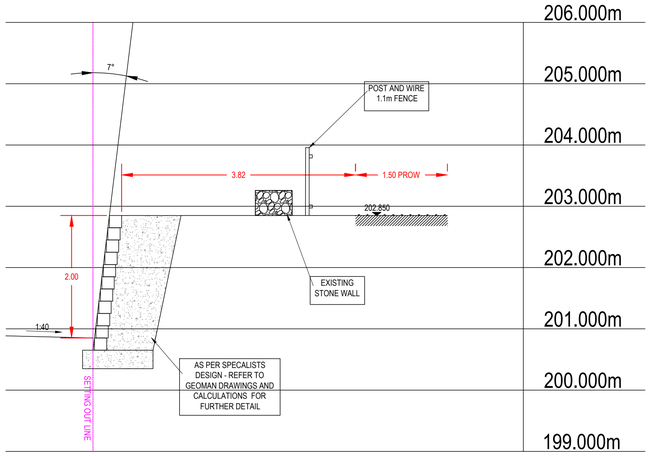

SECTION A-A

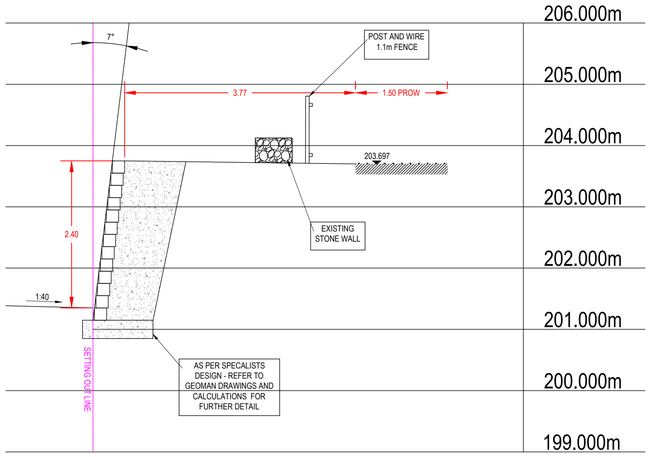

SECTION B-B

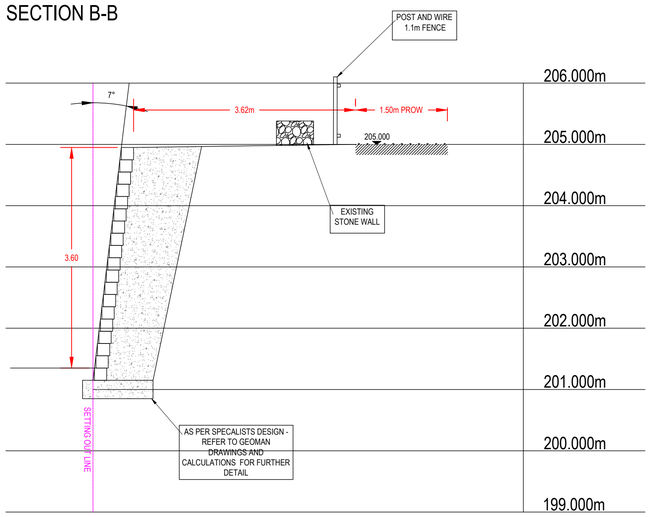

SECTION C-C

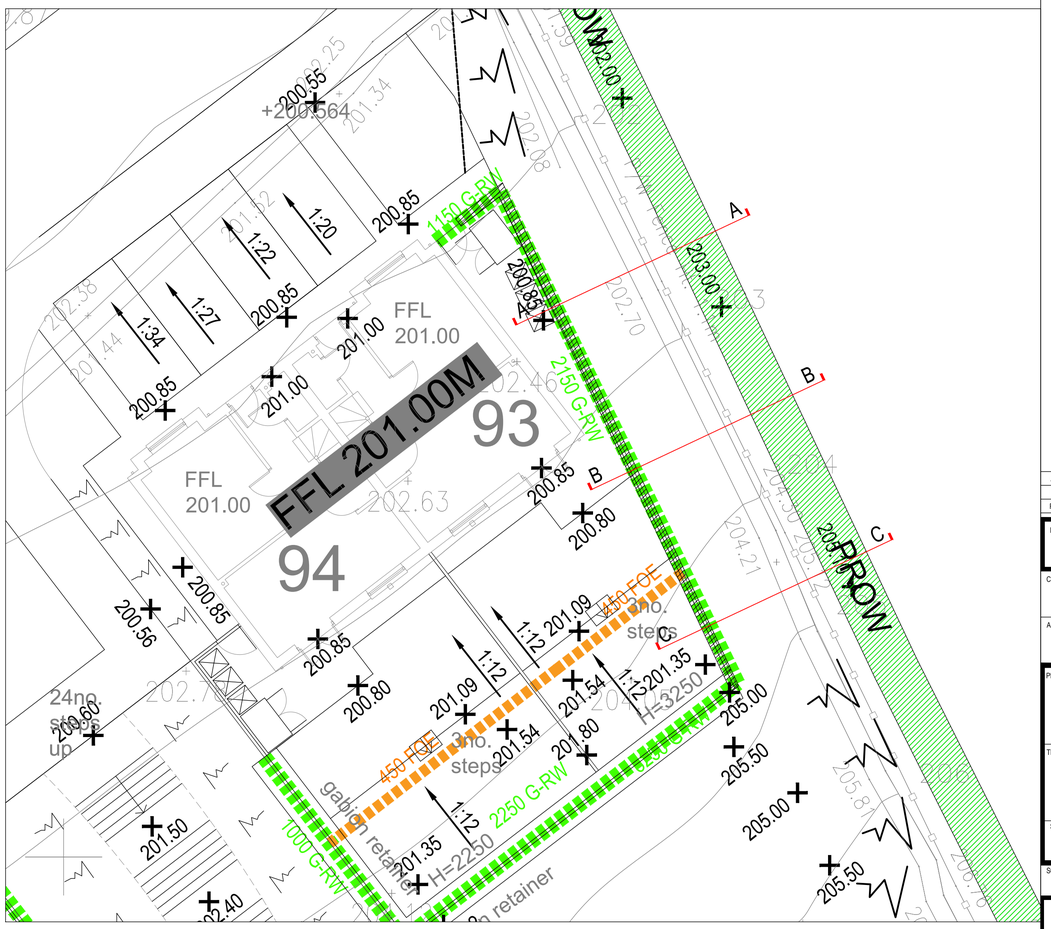

SCALE 1:100

GENERAL NOTES

1. SETTING OUT SHALL BE UNDERTAKEN USING ONLY THE INFORMATION GIVEN. DISTANCES SHOULD NOT BE SCALED FROM THIS DRAWING.
2. IT IS THE RESPONSIBILITY OF THE CONTRACTOR TO VERIFY ALL INFORMATION GIVEN WITH REGARDS TO EXISTING SERVICES AND DRAINAGE CONNECTIONS ETC. PRIOR TO COMMENCING THE WORKS. THE RATES SHALL INCLUDE FOR HAND DIG AROUND SERVICES WHERE NECESSARY. THE CONTRACTOR SHALL ADHERE TO THE CDM REGULATIONS AT ALL TIME
3. ONLY TRAINED PERSONNEL SHALL BE PERMITTED TO ENTER CONFINED SPACES
4. ALL OPENING NOTICES ETC. AS REQUIRED UNDER HIGHWAYS ACTS ETC. ARE TO BE OBTAINED PRIOR TO APPLICABLE.
5. SLAB LEVELS SHALL NOT BE VARIED WITHOUT REFERENCE TO THE ENGINEER FOR GUIDANCE

REV	DATE	DESCRIPTION	BY	CHK	APP
AB1	22.11.2024	AS BUILT ISSUE	JJR	JJR	JCM
P01	28.06.2023	PRELIMINARY ISSUE	JPR	JCM	JCM

DRAWING STATUS: **AS BUILT**

CLIENT: CASEY

ARCHITECT: TADW

PROJECT: BROAD OAK, LINTHWAITE

TITLE: PLOTS 93-94 - PROW SECTIONS

STATUS:	PROJECT NUMBER	DRAWING No:	REV:
S2	219-174	BRO-AJP-00-ZZ-DR-C-1460	AB1

SCALE @ A1:	DESIGNED:	DRAWN:	CHECKED:	APPROVED:	DATE:
1:50 - 1:100	JCM	JPR	JCM	JLS	JUNE 2023

AJP consulting engineers
0151 227 1462 info@ajpltd.co.uk 1 Dale Street, Liverpool, L2 2ET