EAST ELEVATION
1:100

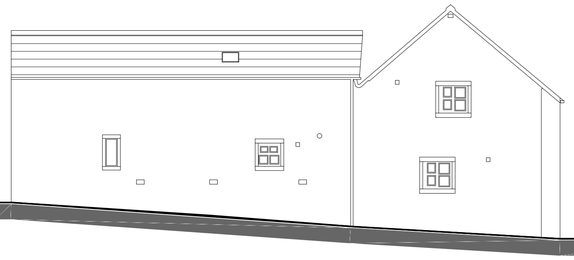

WEST ELEVATION
1:100

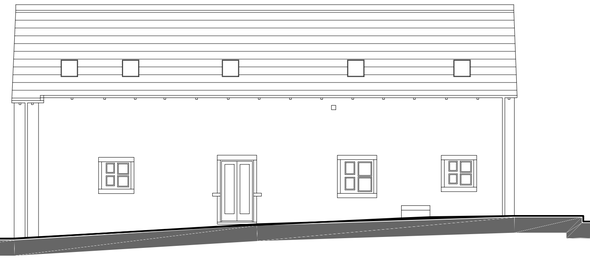

SOUTH ELEVATION
1:100

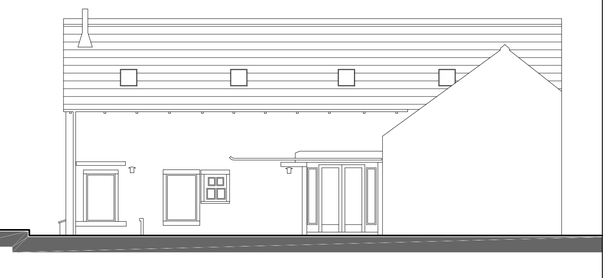

NORTH ELEVATION
1:100

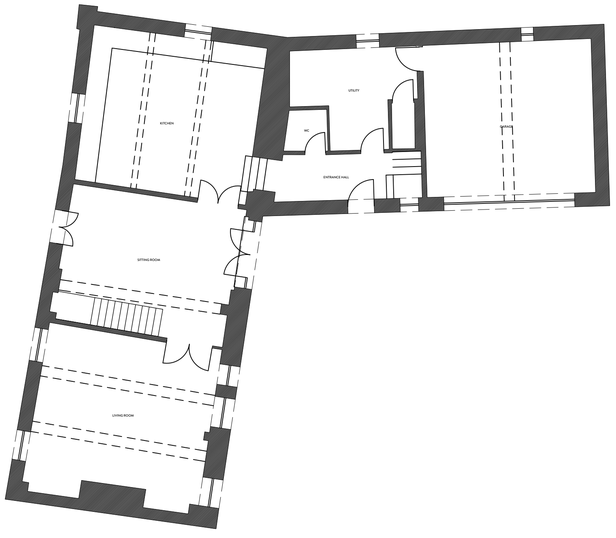

GROUND FLOOR PLAN
1:50

FIRST FLOOR PLAN
1:50

2021 NORTHERN DESIGN AWARDS FINALIST

2022 Best of Houzz Service

BUILD 2021 Home Builder Awards

BUILD Architecture Awards 2019

REVISION	DESCRIPTION	DATE
-	-	-
-	-	-
-	-	-
-	-	-
-	-	-
-	-	-
-	-	-
-	-	-
-	-	-
-	-	-
-	-	-

NOTES

STATUS
PLANNING DRAWING

ORANGE DESIGN STUDIO.
ARCHITECTURAL PRACTICE

hello@orangedesignstudio.co.uk
59A, Huddersfield Road, Mirfield, WF14 8AA
orangedesignstudio.co.uk
01924 650930

COPYRIGHT © ORANGE DESIGN STUDIO LIMITED

PROJECT TITLE: TENTER HOUSE COURT

DRAWING TITLE: AS BUILT GA

SCALE	DRAWN	CHECKED	PROJECT REFERENCE
1:100	CF	JH	ODS_

PAPER SIZE	DWG NUMBER	DATE	REVISION
A1	(20)002	21/02/25	/

CLIENT: MR. & MRS FIELD