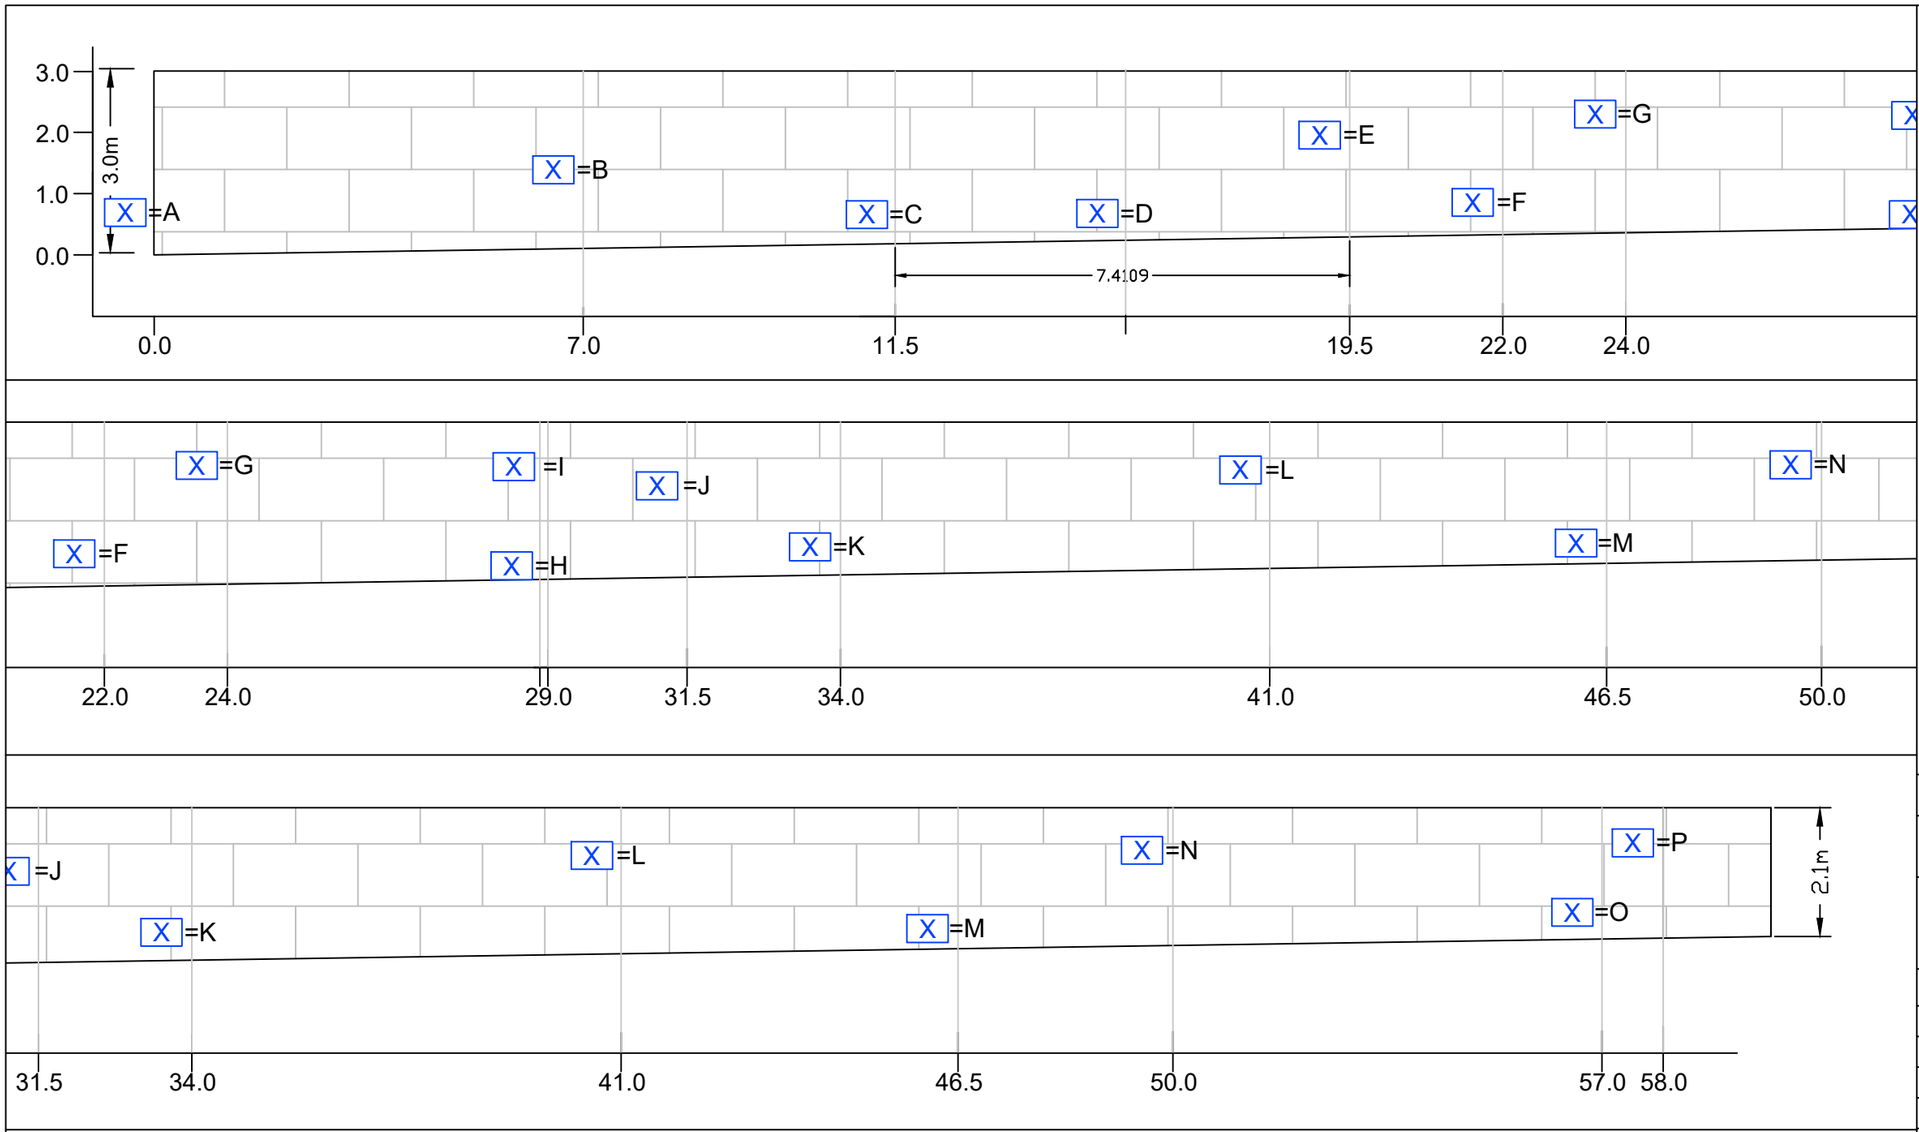

NOTES

1. THIS DRAWING IS PRODUCED FOR USE IN THIS PROJECT ONLY AND MAY NOT BE USED FOR ANY OTHER PURPOSE. THE CONSULTING ENGINEERS ACCEPT NO LIABILITY FOR THE USE OF THIS DRAWING OTHER THAN THE PURPOSE FOR WHICH IT WAS INTENDED IN CONNECTION WITH THIS PROJECT AS RECORDED ON THE TITLE BLOCK FIELDS 'PURPOSE FOR ISSUE' AND 'FILE STATUS CODE'.
2. THIS DRAWING MAY NOT BE REPRODUCED IN ANY FORM WITHOUT PRIOR WRITTEN AGREEMENT FROM ADVANT ENGINEERS.
3. DO NOT SCALE FROM THE DRAWING, USE WRITTEN DIMENSIONS ONLY.
4. ALL DIMENSIONS ARE IN MILLIMETRES UNLESS OTHERWISE SPECIFIED.
5. DISCREPANCIES MUST BE REPORTED BACK TO THE ENGINEER PRIOR TO CONSTRUCTION.
6. THIS DRAWING TO BE READ IN CONJUNCTION WITH ALL RELEVANT ADVANT ENGINEERS DRAWINGS AND SPECIFICATIONS.

REV	AMENDMENTS	BY	DATE
A	INITIAL ISSUE	MJM	20.07.25

FOR APPROVAL

STATUS		CHK'D
PRELIMINARY		MJM
FOR COMMENT		MJM
FOR APPROVAL		MJM
FOR CONSTRUCTION		
AS BUILT		

KEYS

A =	Chainage 0m - 1.5m (Large Stone)
B =	Two gaps in wall.
C =	Wall bowing outwards.
C =	Start of what appears to be a previous repair.
D =	Wall has been rebuilt at some point.
E =	Wave in face of wall.
F =	Irregular strack stones near top of wall.
G =	Vegetative growth along top of wall.

H =	Missing Stones.
I =	Missing Stones.
J =	Missing Stones.
K =	Loose stones.
L =	Loose stones.
M =	Loose stones.
N =	Missing Stones.
O =	Damage Stones.
P =	Large Stones.

advant ENGINEERS
Unit 6 Benton Office Park, Bennett Avenue
Horbury, Wakefield, West Yorkshire, WF4 5RA
01924 654108
wakefield@advantengineers.co.uk

DRAWN	RR	CHK'D	MJM
SCALE	1:100 @ A3	DATE	20.07.25

CLIENT	CONTRACT	TITLE
ORION HOMES LIMITED	BANKFIELD DRIVE, HOLMBRIDGE	RETAINING WALL SURVEY

JOB No	DRG No	REV
21043	137	A