

Key  
 Convex side (Plus value) 0.001  
 Concave side (minus value) 0.004  
 - 0.003

NOTES: SURVEY DIMENSION

2. Level errors shown  $\oplus$

3. Errors from design shown  $\leftarrow$  or  $(\pm 0)$

Comments.: To be read with DWG ; - GH -001

Sheet 2 Of 2

Ref. Drawing No.: GH-002

Report No.: 1

Type of Survey: Elevation Asbuilt - Survey results

Title.: George Hotel Elevation Asbuilt

Location: Huddersfield

Date Surveyed: 6/12/24

Surveyed By: Simon

Survey Chk'd By.: Simon


Site: George Hotel

Date Drawn: 6/12/24

Drawn By: Simon

Drq Chk'd By.: Simon

Simon J. Geddes  
 Senior Engineer  
 simon.geddes@gmicon.co.uk  
 Mob: 07583677421

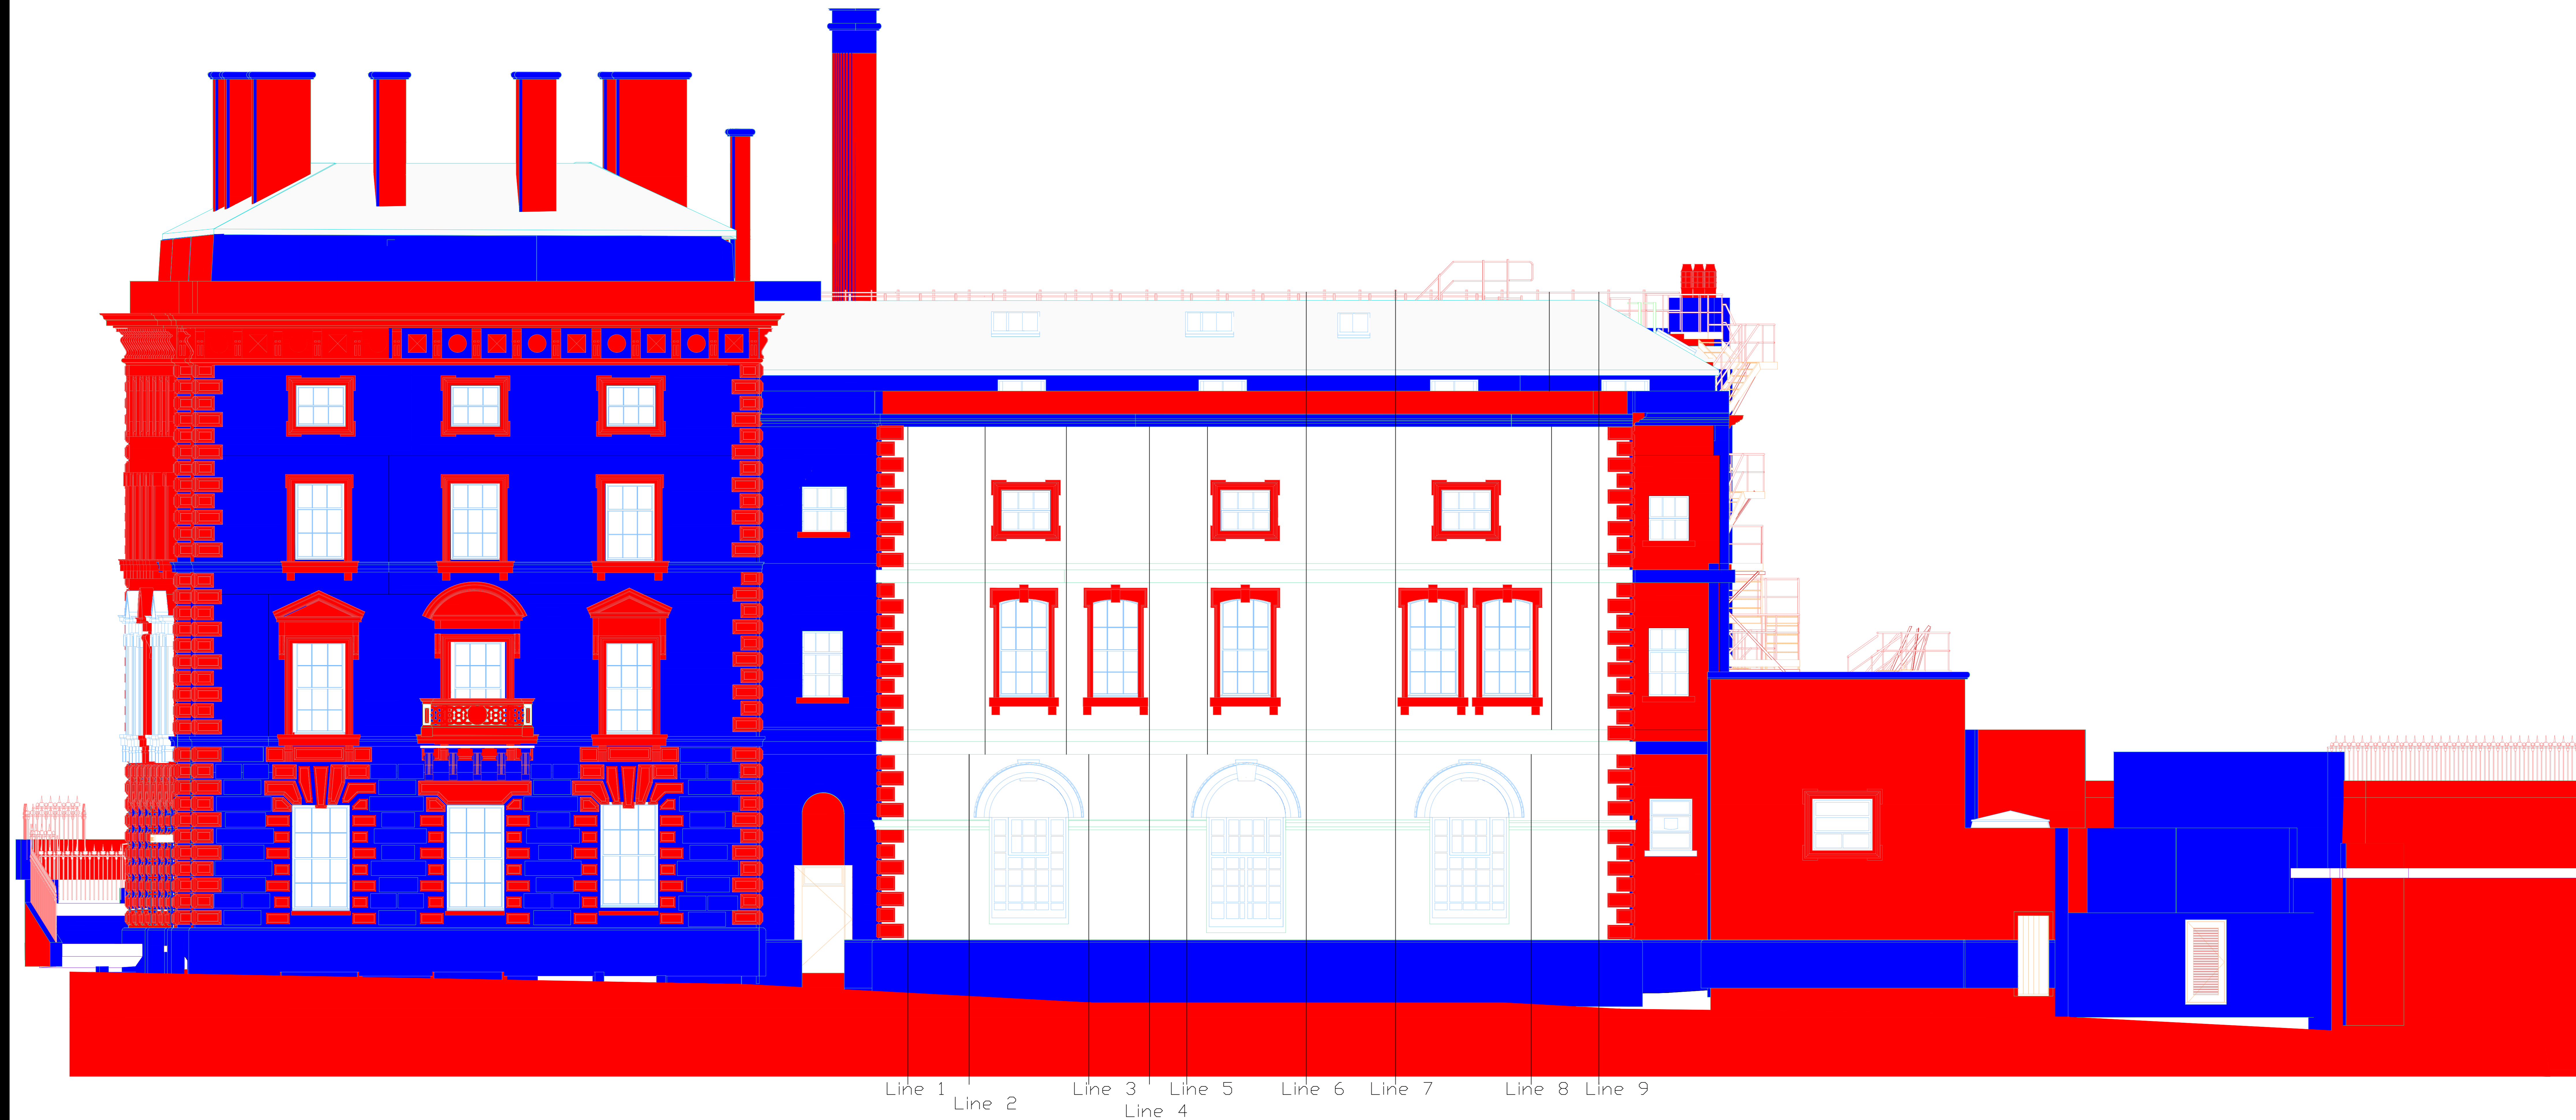

**GM**  
 GEDDES  



Simon J. Geddes  
 Senior Engineer  
 simon.geddes@gmicon.co.uk  
 Mob: 07583677421

NOTES:  2. Level errors shown  $\oplus$  3. Errors from design shown  $\leftarrow$  or  $(\pm 0)$

Ref. Drawing No.: GH -001

Type of Survey: Elevation As-built

Location: Huddersfield

Site: Georges Hotel

Comments.: To be read with DWG GH-002

Report No.: 1

Title.: George Hotel Elevation Asbuilt

Date Surveyed: 6/12/24	Surveyed By: Simon	Survey Chk'd By.: Simon
Date Drawn: 6/12/24	Drawn By: Simon	Drg Chk'd By.: Simon