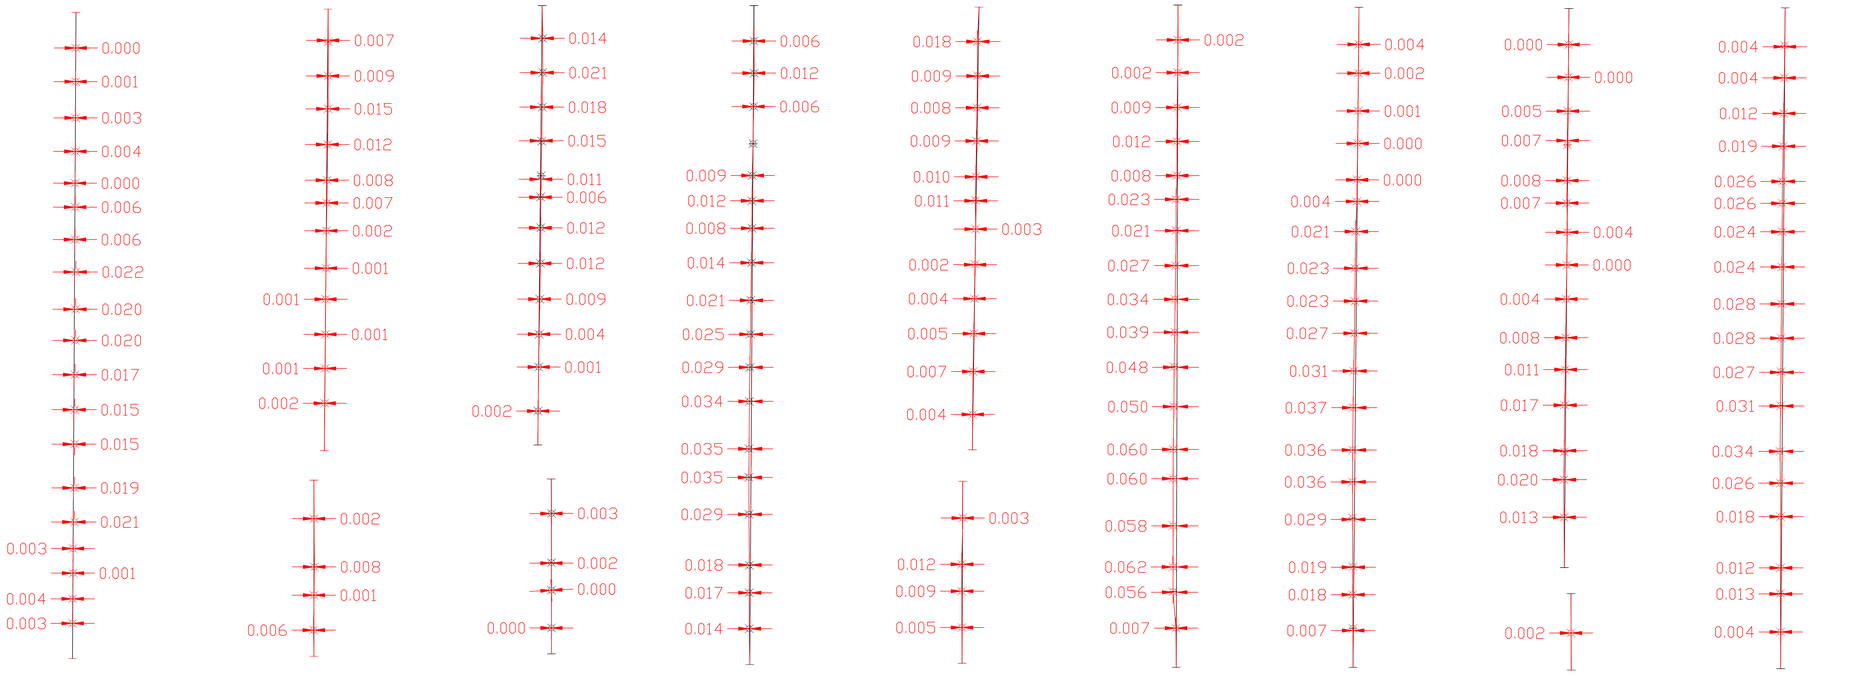

Key

Convex side
(Plus value)

0.001
0.004
0.003

Concave side
(minus value)

Simon J. Geddes
Senior Engineer

simon.geddes@gmicon.co.uk

Mob:07583677421

NOTES: SURVEY DIMENSION 2. Level errors shown ±0 3. Errors from design shown ◄► or (±0)

Comments.: To be read with DWG ;- GH -001

Sheet 2 Of 2

Ref. Drawing No.: GH-002

Report No.: 1

Type of Survey: Elevation Asbuilt – Survey results

Title.: George Hotel Elevation Asbuilt

Location: Huddersfield

Date Surveyed: 6/12/24 | Surveyed By: Simon | Survey Chk'd By.: Simon

Site: George Hotel

Date Drawn: 6/12/24 | Drawn By: Simon | Drg ChK'd By.: Simon



Simon J. Geddes
Senior Engineer

simon.geddes@gmicon.co.uk

Mob:07583677421

NOTES: SURVEY DIMENSION 2. Level errors shown ±0 3. Errors from design shown ◄► or (±0)

Comments.: To be read with DWG GH-002

Sheet 1 Of 2

Ref. Drawing No.: GH -001

Report No.: 1

Type of Survey: Elevation As-built

Title.: George Hotel Elevation Asbuilt

Location: Huddersfield

Date Surveyed: 6/12/24 | Surveyed By: Simon | Survey Chk'd By.: Simon

Site: Georges Hotel

Date Drawn: 6/12/24 | Drawn By: Simon | Drg ChK'd By.: Simon