


Existing Elevation - 1
Scale 1:100 @ A1

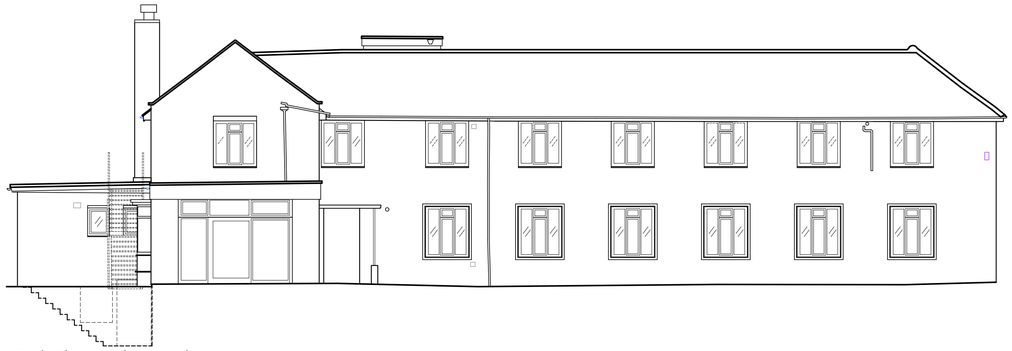


Existing Elevation - 2
Scale 1:100 @ A1



Existing Elevation - 3
Scale 1:100 @ A1




Existing Elevation - 4
Scale 1:100 @ A1

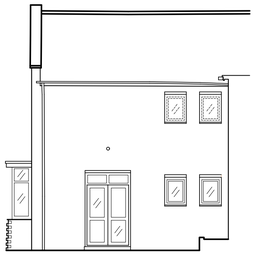

Existing Elevation - 5
Scale 1:100 @ A1



Existing Elevation - 2A
Scale 1:100 @ A1

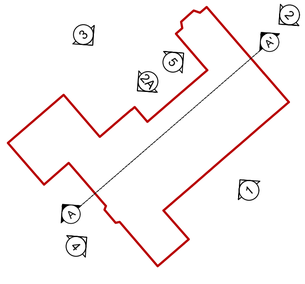

SPIRE Architecture

©2025

SPIRE ARCHITECTURE
BRADFORD
WEST YORKSHIRE
INFO@SPIREDESIGNSTUDIO.CO.UK

PROJECT ADDRESS:

33 LEE ROAD,
DEWSBURY
WF13 3BE
UNITED KINGDOM

DRAWING TITLE: AS BUILT ELEVATIONS

JOB DWG NO: 24-P-149

CLIENT:

REVISION:

REV / DATE	DESCRIPTION

NOTES
1. This drawing and the copyright and patents herein are the designers property and may be used or reproduced only under contract.
2. Contractors and sub contractors must check and agree all dimensions before preparing shop drawings or commencing work on site.
3. Contractors are responsible for informing the Designer of any discrepancy discovered on this drawing or between this drawing and any other related documents issued in respect of this work.
4. Written dimensions only are to be used from this drawing. If any doubt exist the contractor must ask for clarification. On no account must the contractor scale off this drawing.
5. If no site investigation has been carried out prior to commencement of works. Contractor by make trial holes to test suitability of ground for proposed foundations.
6. All work must be carried out in accordance with the current Building Regulations, Codes of Practice and British Standards. If any doubt exists the contractor must ask for clarification.
7. All references refer to accompanying specification
8. Information is based on OS map and received information and is subject to full topographical and building survey. Assumed site boundary and site constraints subject to confirmation.

NOT FOR CONSTRUCTION

0 10 20 30 40 50 mm
SCALE 1:1

SCALE: 1:100

X102

DRAWN BY: ZEESHAN BABAR

DATE: 12/12/2025