Only figured dimensions should be used.

Scaled dimensions should be checked with the Architect.


This drawing together with the design, is the property and copyright of the Architect and must not be reproduced without written permission

ACUMEN SPOT LEVELS TAKEN ON SITE 18.11.25

RED DENOTES FILL AMOUNT EXCEEDING 200mm

BLUE DENOTES FILL AMOUNT NOT EXCEEDING 200mm

DENOTES INDICATIVE ZONE OF EXCEEDING FILL

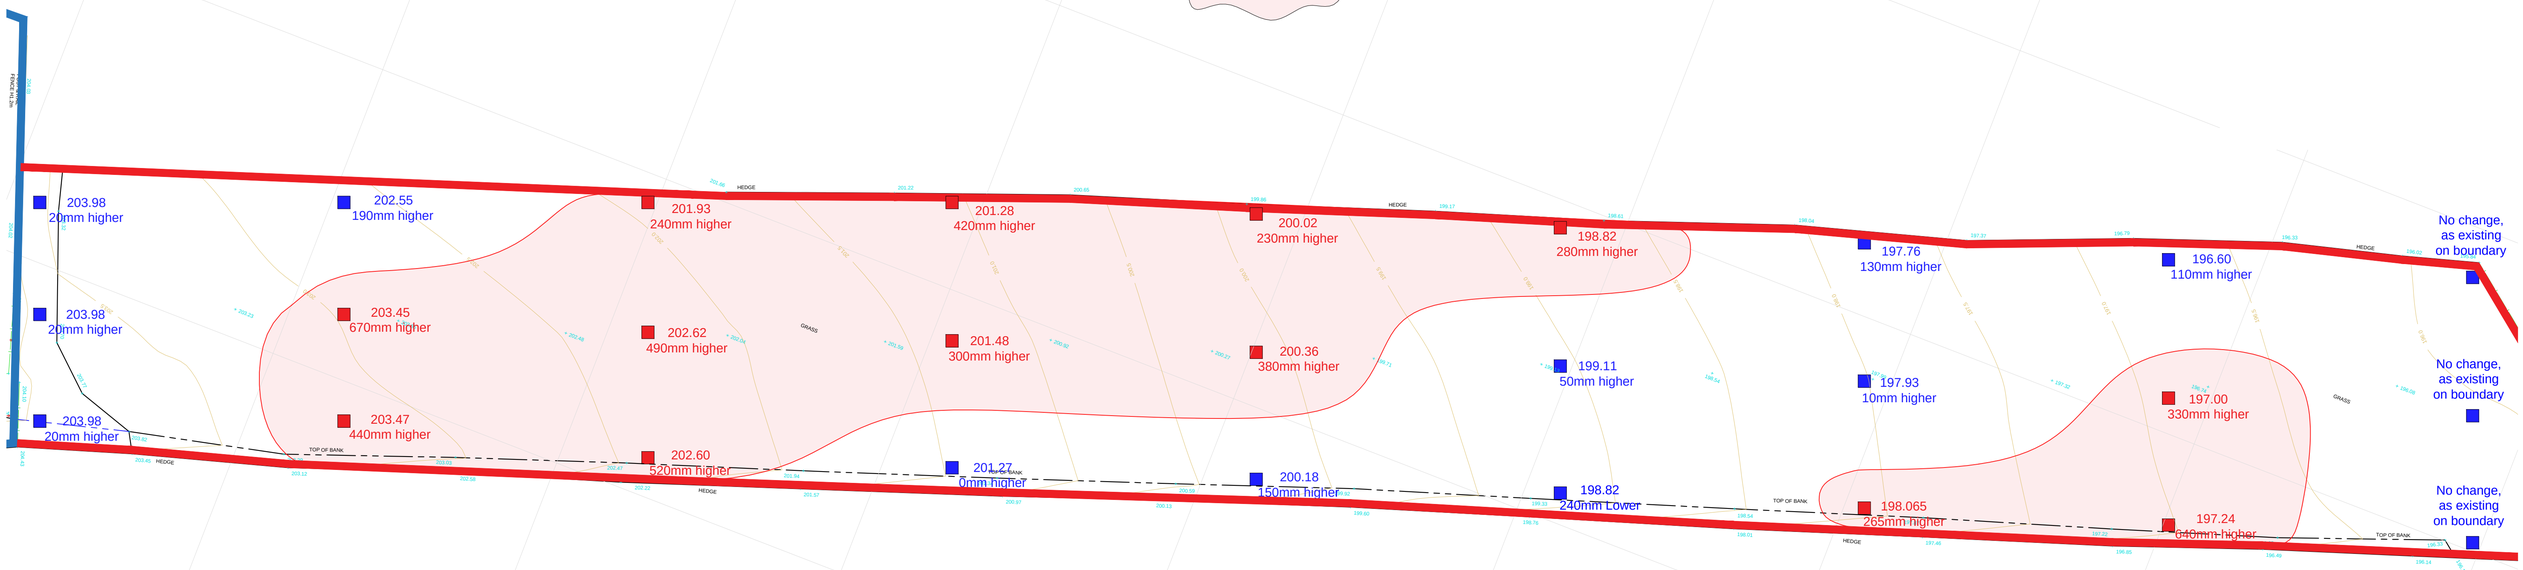

DO NOT SCALE OFF THIS DRAWING

rev	description	drwn	auth	date

ACUMEN
DESIGNERS & ARCHITECTS
acumenarchitects.co.uk 01484 546 000
Headrow House, Old Leeds Road, Huddersfield, HD1 1SG

Client
MR & MRS FORSTER

Project
ENGINEERING OPERATIONS @
22 STRINGER HOUSE LANE

Project No	Drawing No	Rev
2721	(100) 13	

Description
AS BUILT (CURRENT) SPOT LEVELS

Scale	Date Drawn	Drawn By	Authorised By
1:200@ A1	19.11.25	AO	JC

File: C:\Acumen Admin\Jobs\Documents\2721\Working Drawings\Cad\2721 (100) 13 AS BUILT (CURRENT) SPOT LEVELS.dwg Plotted by: Acumen

Purpose of Issue
Planning ○ Building Regs ○ Tender ○ Construction ○ Comment ○ Info ●