


# Prefabricated Gable End

Roof Pitch: 30°,  
 Stone Type: 140mm Course  
 Approx Weight 165/Kg Un Pointed

Please provide installation guides showing position of roof underlay, battens, fixings etc

- Notes:-
1. Roof pitch and brick type to be confirmed.
  2. Chimneys supplied un pointed.
  3. Lead flashing fixed by site to Lead Sheet Association Working Standards.
  4. 3 Layers of roofing felt to be fitted under chimney.
  5. To be read in conjunction with standard method statement and fixing guide.
  6. All Fixings to be checked by project Engineer.

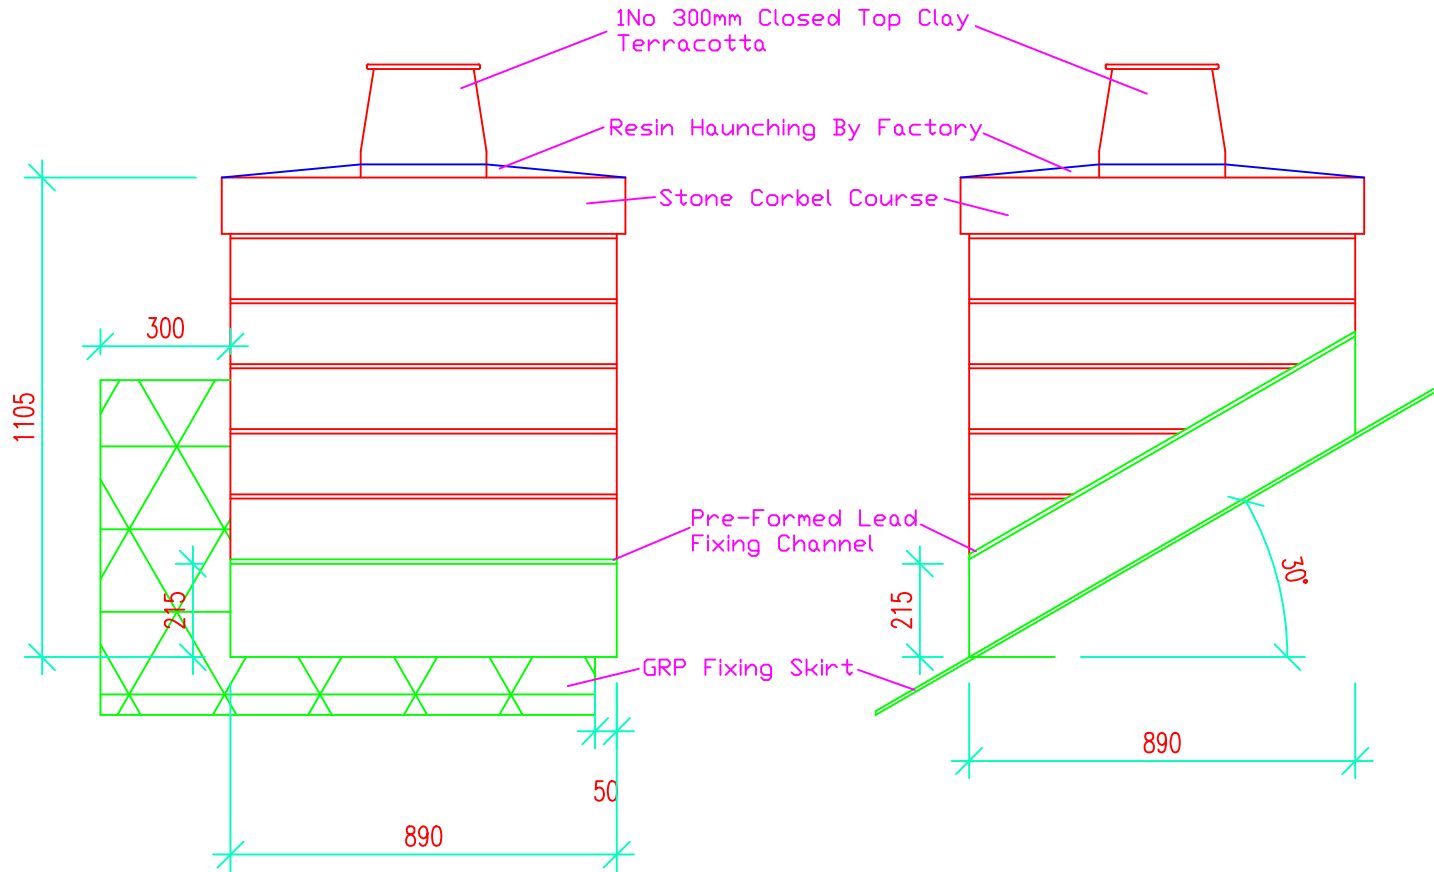

**COMMENT STATUS**

A No further comment

B Comments noted and to be added prior to fabrication

C Significant Comments resubmit revised information

Submission was reviewed for design conformity and general conformance to contract documents only. Contractor is responsible for confirming and correlating dimensions at job sites for tolerances, clearance, quantities, fabrication processes and techniques of construction, coordination of his or her work with other trades and full compliance with contract documents and Building Regulations.

Name: **Clive Webb**  
 Date: **23/08/2022**

Client: Gibbs & Dandy

Contract:  
 Brierstone Ltd  
 Carr Top Lane  
 Golcar  
 Huddersfield  
 HD7 4JB

Job No.	Drawing No.	Revision	Scale	NTS
FI/GB	0002		By AW	A1

Drawing Title  
 890 x 890 x 1105mm Gable Mono Pitch

**gb** Construction Supplies Ltd  
 Triton House,  
 Hare Park Lane,  
 Liversedge, WF15 8HN  
 Tel: 01274 870044

**CGMA**  
 CONSTRUCTION GLASSFIBRE  
 MANUFACTURERS ASSOCIATION

APPROVED

A Member of the International Glasfibre Reinforced Cement Association.  
 GRCA Approved Manufacturers Scheme  
 A Member of the Concrete Society

**DRAWING NOTES**

Whilst every care is taken to ensure details contained herein are correct and accurate, GB GB Architectural Cladding Products Ltd. (GBACPL) accept no liability whatsoever for any information given.  
 It is the responsibility of all project professionals to ensure these representations are suitable and fit for purpose. Any drawing work performed by GBACPL is purely advisory and should be viewed in that light.  
 Please also note that delivery lead times are only applicable from the date of formal and written approval of all details. An order without approval of all detail will not determine a given delivery date.  
 It is the responsibility of project professionals to ensure all current drawing documentation is in the possession of GBACPL.