This drawing along with the design is property and copyright of Hill Rise Architecture Ltd. and shall not be reproduced without express written consent.

This drawing should be read in conjunction with associated drawings, specifications and other consultant information.

Only figured dimensions should be used, any dimensions should be site checked prior to construction.


Any discrepancies shall be reported to the architect. If in doubt - ask.

0 1 2 3 4 5


GRAPHIC SCALE: 1:50

0 1 2 3 4 5 10

GRAPHIC SCALE: 1:100

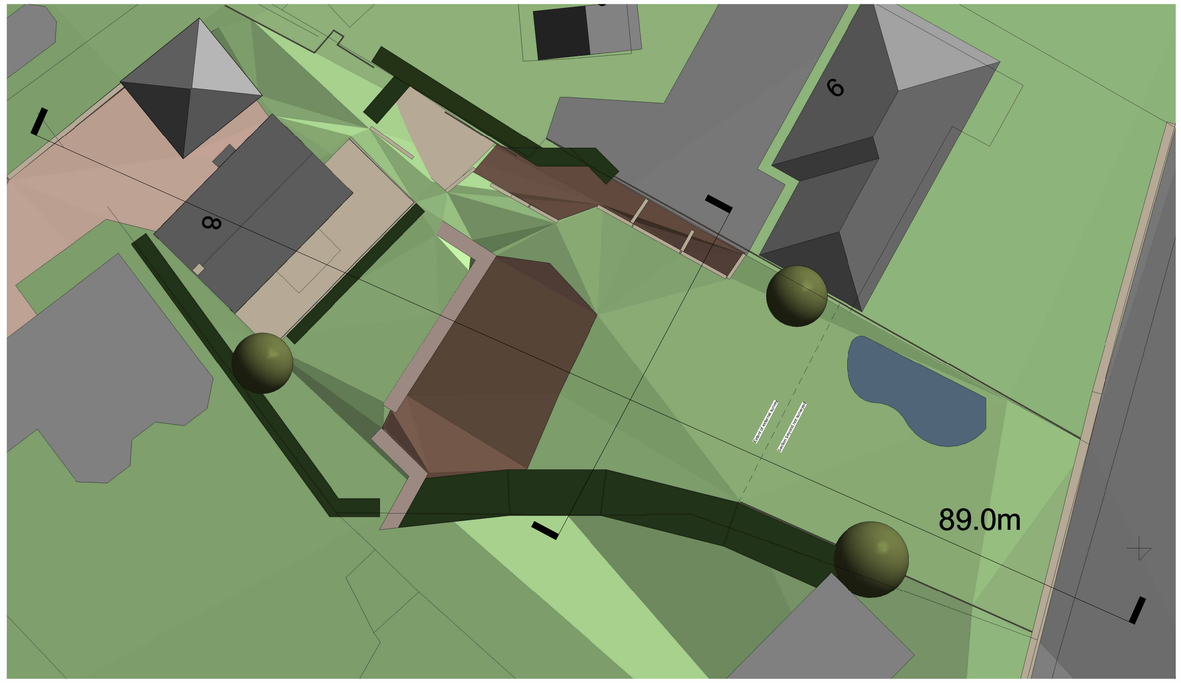

PROPOSED (AS BUILT) SITE PLAN
1:200

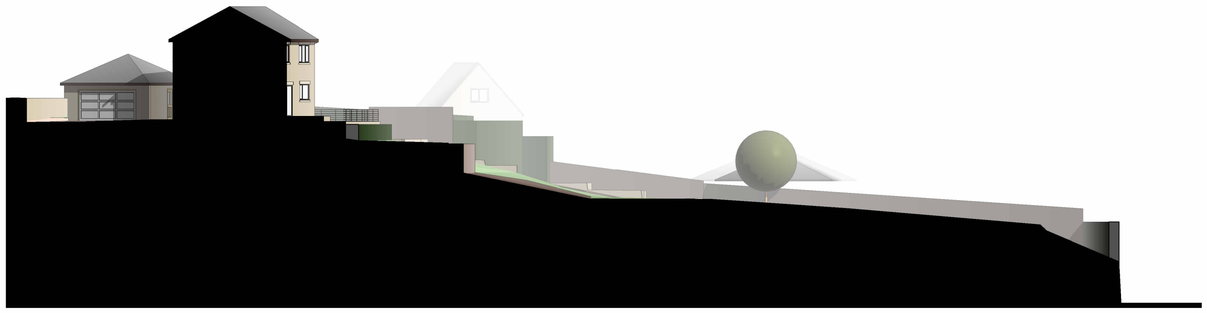

PROPOSED (AS BUILT) LONG SITE SECTION
1:200



PROPOSED (AS BUILT) SHORT SITE SECTION
1:200

Rev No.	Description	Drawn:	Date
P0	Drawing originated for comment	JF	15.06.26

HILL RISE ARCHITECTURE

Client
Mr C Smith

Project
8 St Pauls Road, Kirkheaton

Drawing Title
Proposed (As Built) Site Plan & Sections

Drawing No			Rev No
2026141-103			P0
Scale		Date Drawn	Drawn By
1 : 200	@ A1	Jun'26	JF

Purpose of issue
Planning

hello@hillrisearchitecture.co.uk hillrisearchitecture.co.uk
+44(0)7356 048 202 Hill Rise, 1-3 Chapel Lane, HD8 9SP

RIBA Chartered Practice

arb Architects Registration Board