The contractor must verify all dimensions on site before commencing any work orfabrication drawings. If this drawing exceeds the quantities taken in any way Unite Designs are to be informed before the work is initiated. Only figured dimensions are to be taken from this drawing. Do not scale off this drawing. Drawings are based on Ordnance Survey and / or existing record drawings - design and drawing content isubject to detailed Site Survey, Structural Survey, Site Investigations, Planning and Statutory Requirements and Approvals. Authorised reproduction from Ordnance Survey Map with permission of the Controller of Her Majesty's Stationery Office.Crown Copyright reserved. Unite Designs Copyright.

Drawing Notes:

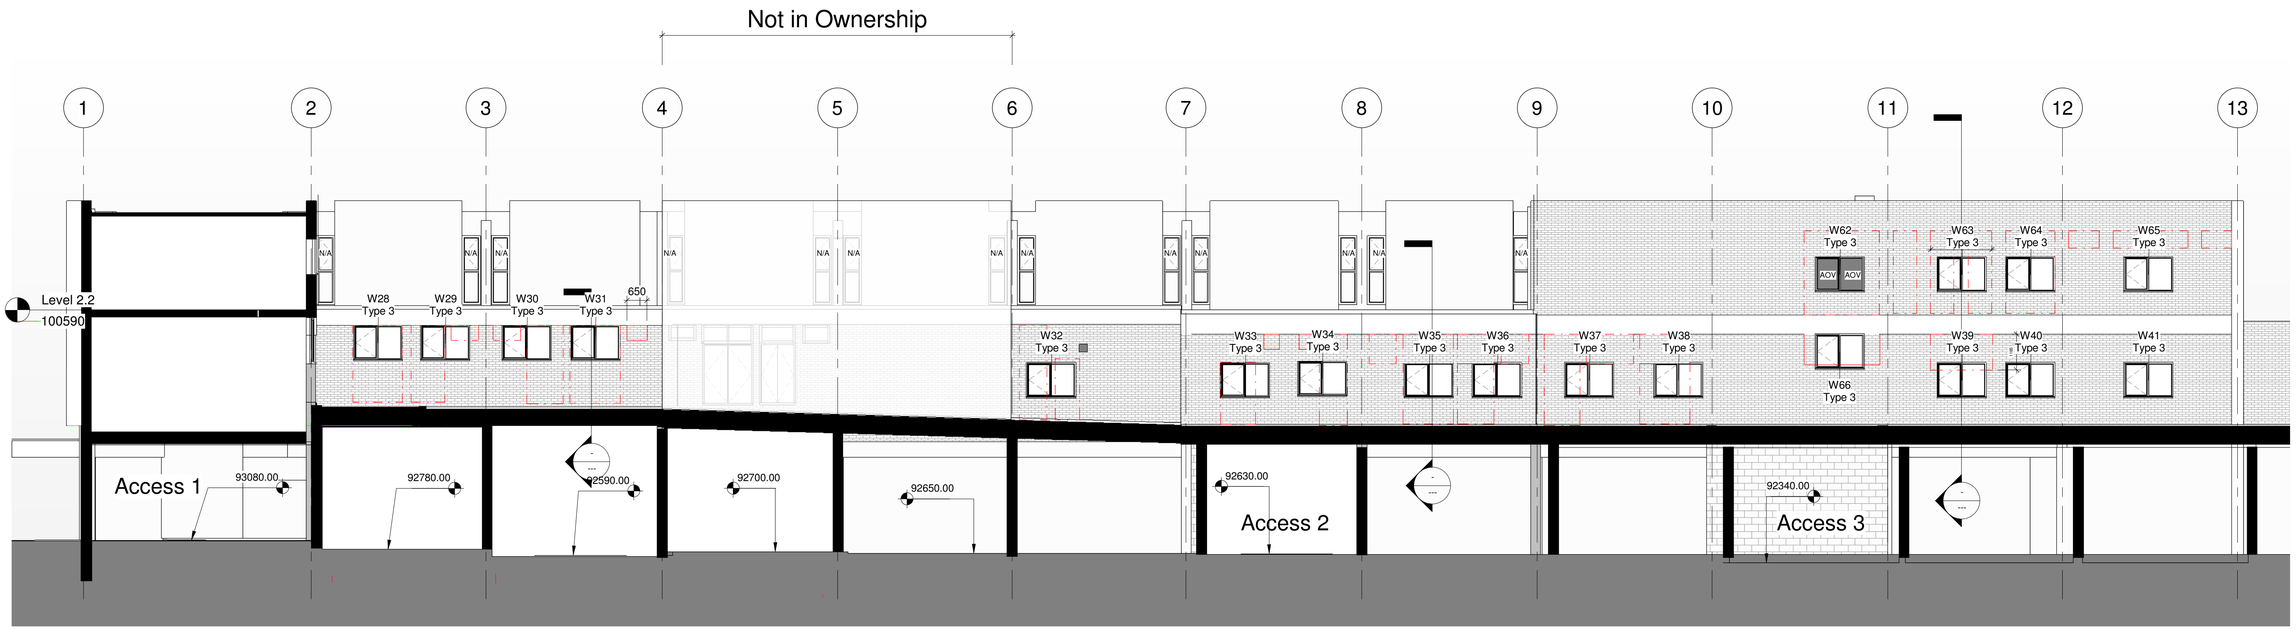

2 Proposed Rear Elevation

1 : 100

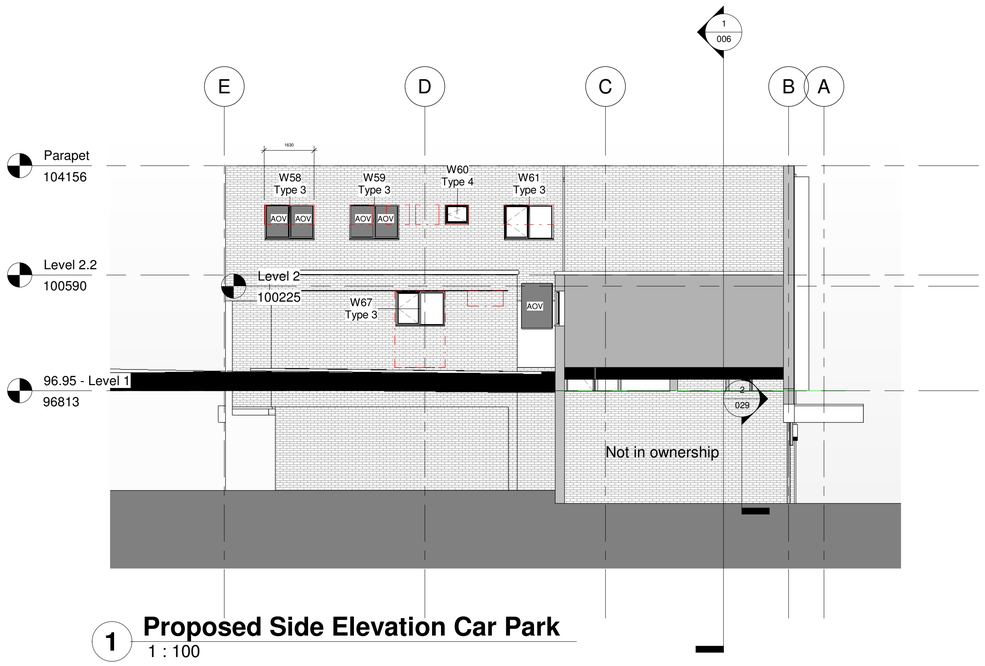

1 Proposed Side Elevation Car Park

1 : 100

Rev:	Description:	Revised By:	Issue Date:

Project:
New Street
Apartments

Drawing
Proposed Rear Elevation and Side

Scale: 1 : 100@A1 | Original Issue Date:

Original Drawn Author | Original Checked Checker

Drawing
UD-640

Revision:

Reason For Issue:
Construction

Unite Designs

T: 07858606182
Mannan_i@hotmail.co.uk