
NOTE
MATERIALS TO MATCH EXISTING
THESE NOTES DO NOT COMPRISE A FULL SPECIFICATION
THEY ARE FOR GENERAL GUIDANCE ONLY AND THEIR
PRIMARY FUNCTION IS TO ASSIST LOCAL AUTHORITY
OFFICERS IN DETERMINING BUILDING REGULATION COMPLIANC
ALL DIMENSIONS MUST BE CHECKED ON SITE PRIOR TO WORKS
STARTING.
ALL WORKS MUST BE CARRIED OUT IN ACCORDANCE WITH
CURRENT BUILDING REGULATIONS, CODES OF PRACTICE AND
PLANNING OFFICERS REQUIREMENTS.
ALL MATERIALS MUST COMPLY WITH CURRENT BRITISH STANDA
IN SITUATIONS USED.

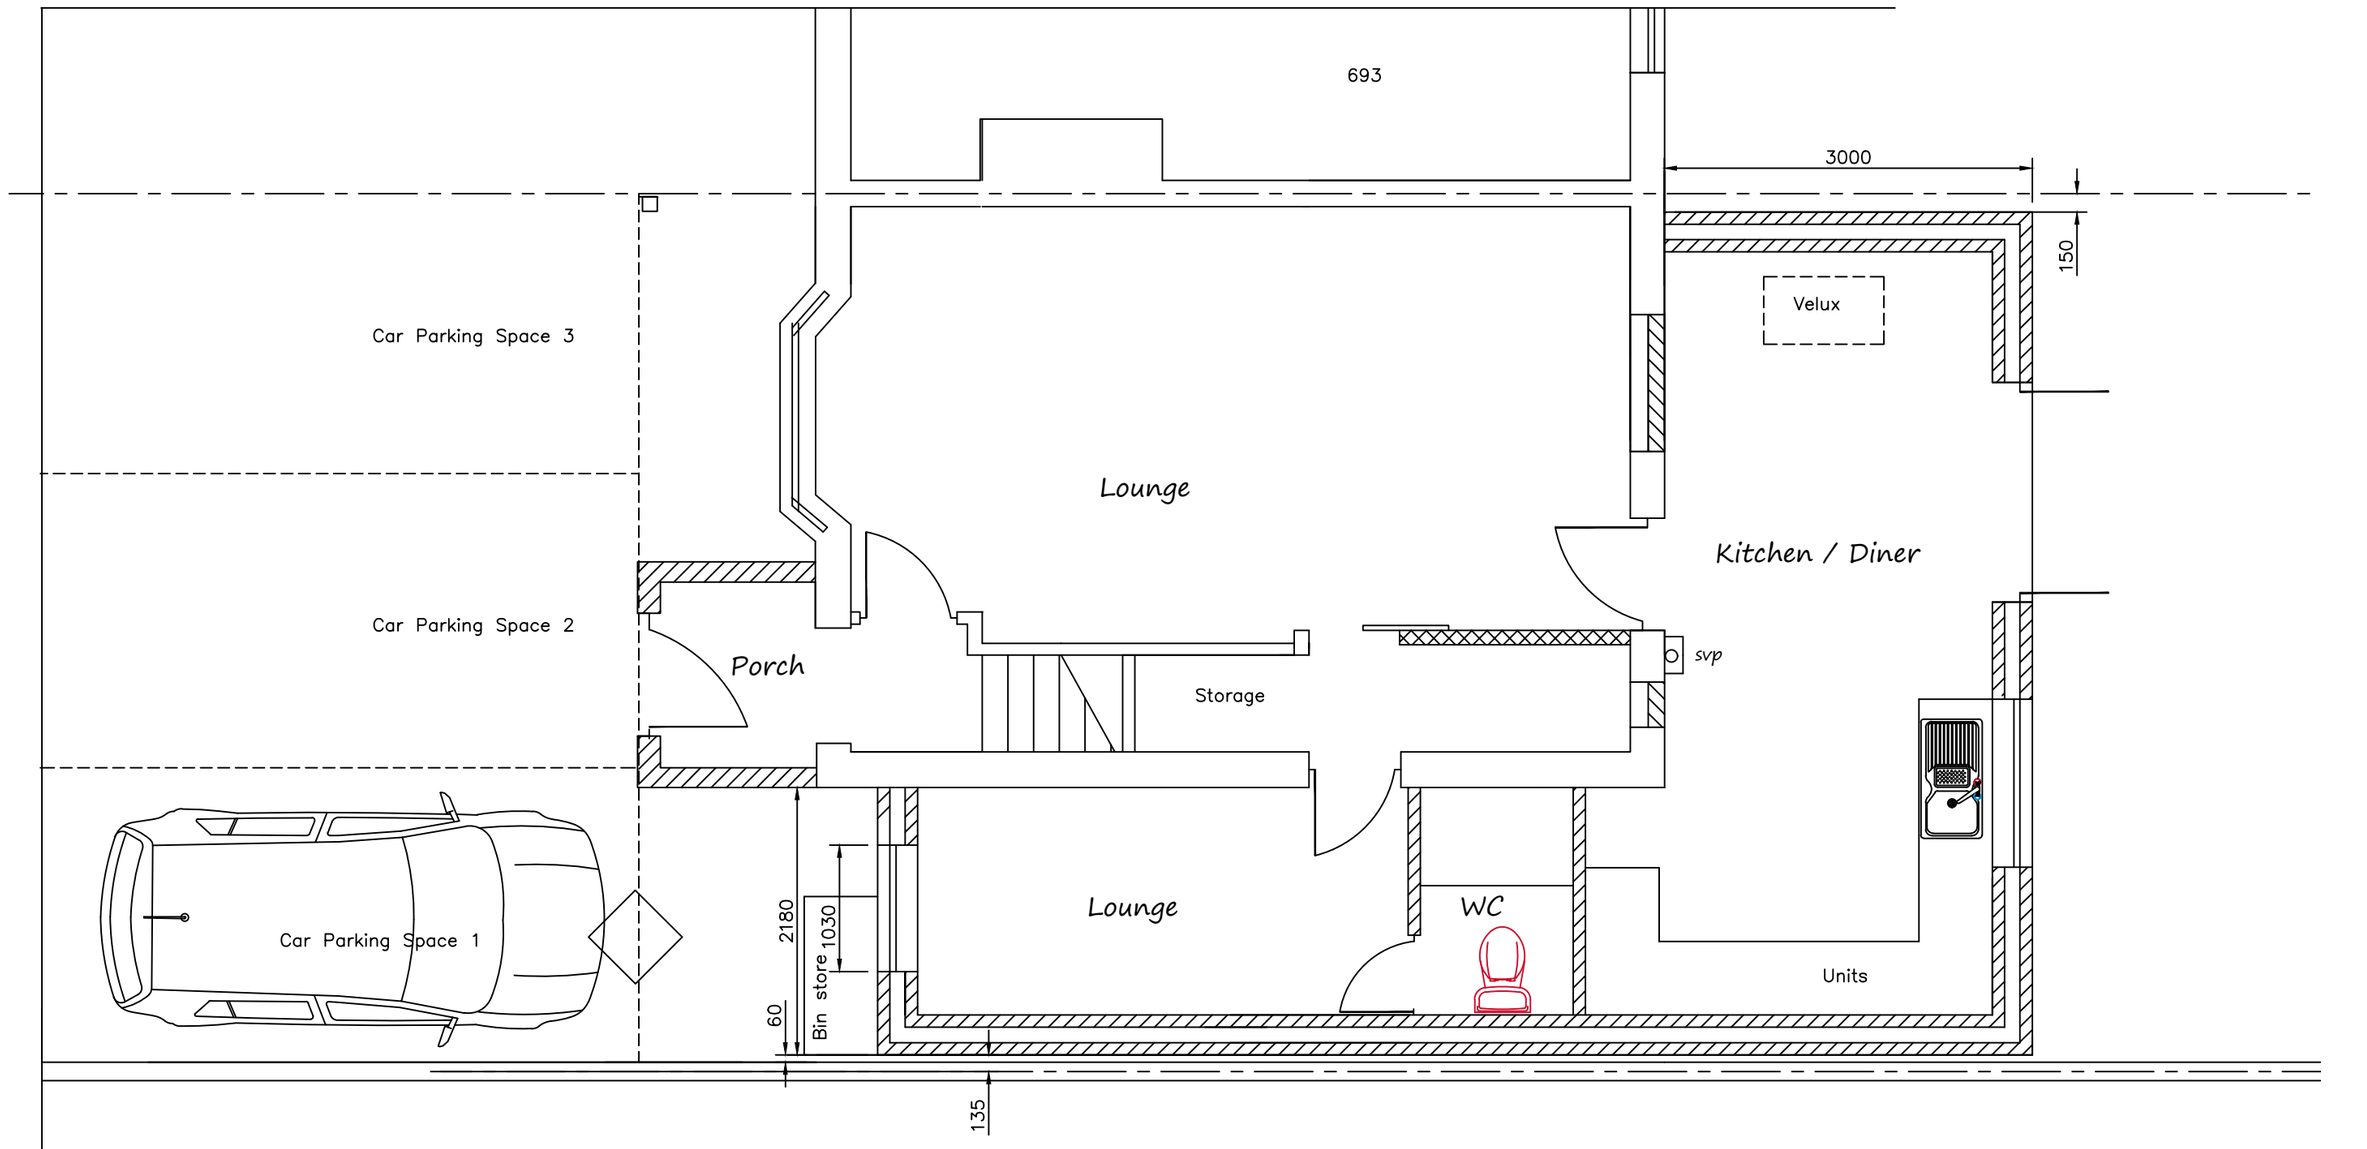

Ground Floor Plan

1:50

697

MIRFIELD DESIGNS
Planning & Building Control Services

Tel: 07877959728
Email: mirfielddesigns@gmail.com

Client	Mr & Mrs Monga
Job	695 Leeds Road Huddersfield
Title	Ground Floor Plan as Built
Drawn By RK	Date Sept 2026
Eng. Check	Scale 1:50
Tech. Check	
Drawing No. 2025 / 486 / 05	Rev.