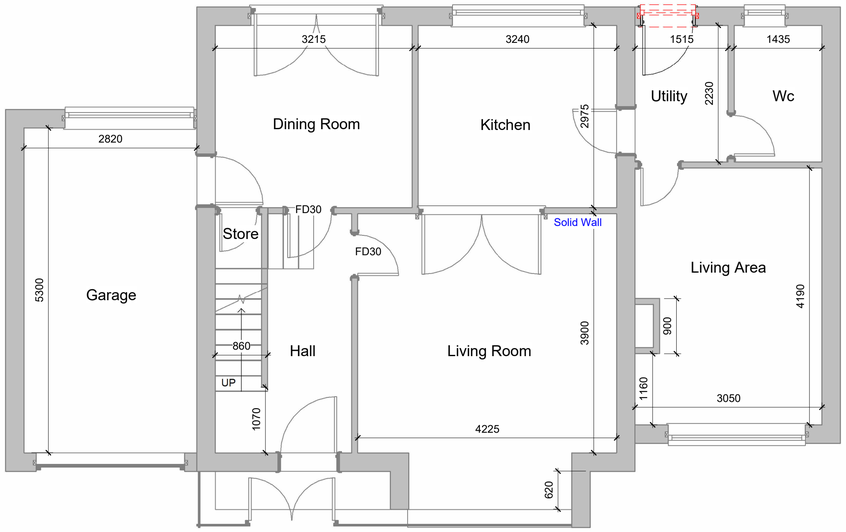

As-Built Ground Floor Plan
1 : 50

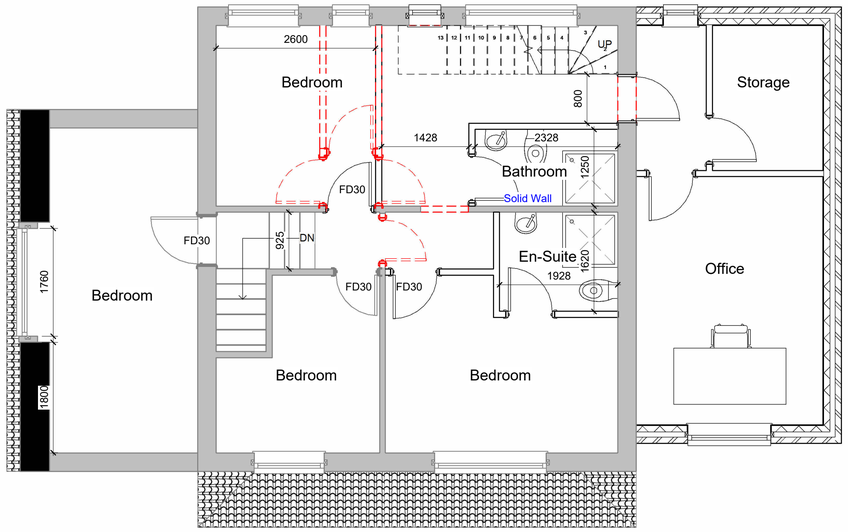

As-Built First Floor Plan
1 : 50

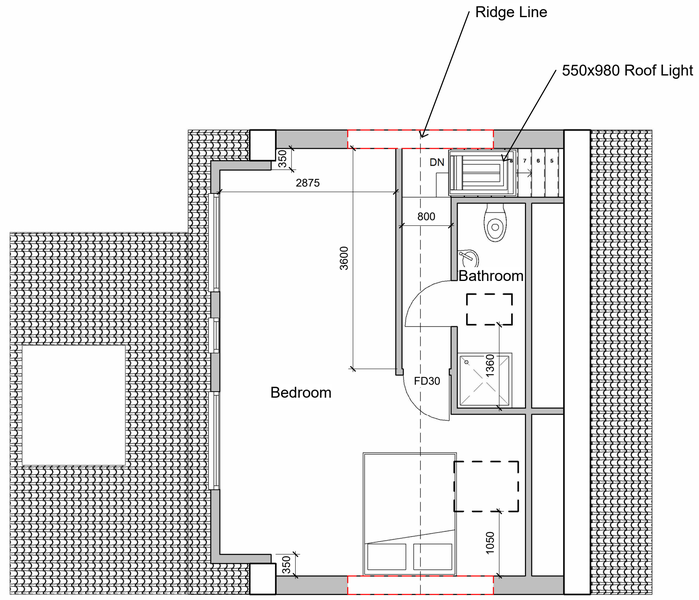

As-Built Attic Plan
1 : 50

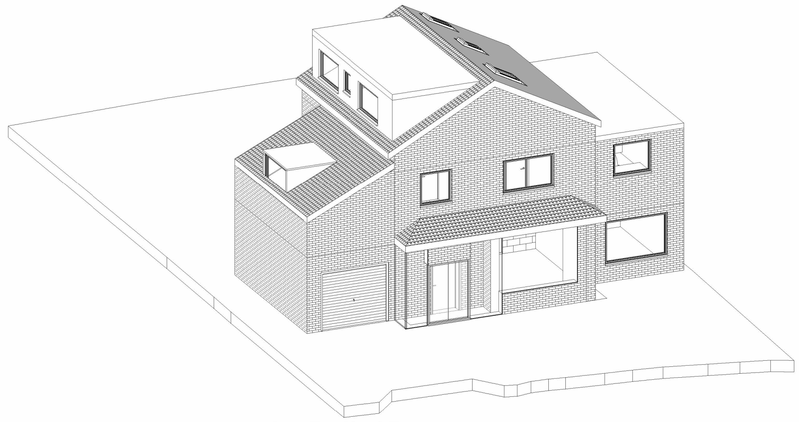

As-Built 3D

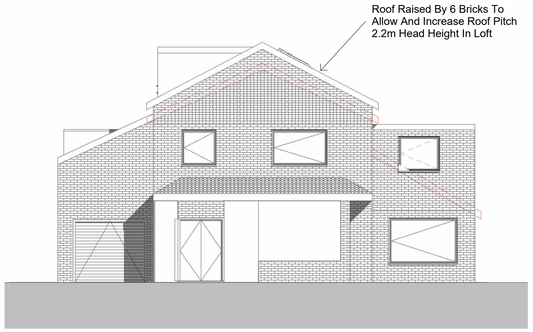

As-Built Front Elevation
1 : 100

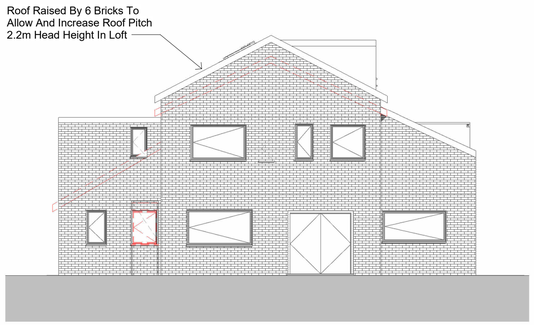

As-Built Rear Elevation
1 : 100

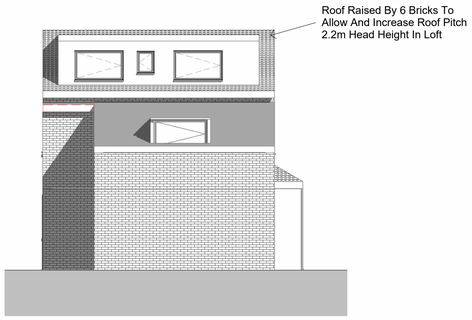

As-Built Left Elevation
1 : 100

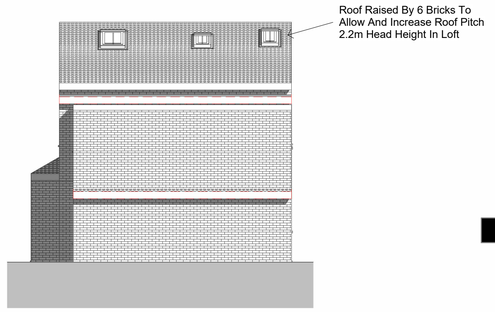

As-Built Right Elevation
1 : 100

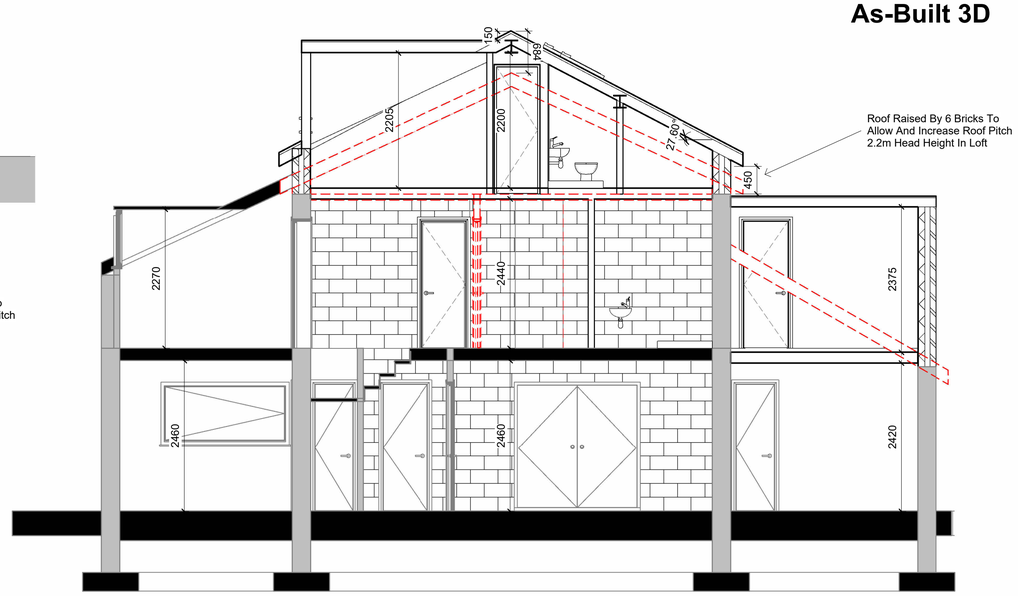

As-Built Section A-A
1 : 50

Note:
All Dimensions Are Approximate
And TBC On Site By Contractor

TREND ARCHITECTURE
T: 01484 941051
plan@trendarchitecture.co.uk
www.trendarchitecture.co.uk

Naeem Builder
81 Springwood Hall Gardens, Huddersfield, HD1 4HA

Drawing Title:
As-Built Grouped Plans

Drawing Number: TR-A26-0403-004	Scale: As indicated@A1
Date: 07/10/26	Revision: Approver
Drawn By: AM	Checked by: JA
Reason For Issue:	